

ADDENDUM ACKNOWLEDGMENT

ADDENDUM NO. 01

Dated: May 19th, 2023

Opening Date: May 23rd, 2023 @ 3:00 pm

NOTICE

It is the sole responsibility of the bidder to ensure that it has received any and all Addenda and the Philadelphia Redevelopment Authority may in their sole discretion reject any bid for which Addenda have not been executed and returned.

PROPOSAL FOR

Project No.: 16368E-02-04

Description: Kingsessing Recreation Center, Building & Site Package 1: Exterior Envelope Repairs & Improvements

IS AMENDED AS FOLLOWS:

1. Amendments will be posted in [<http://www.phdcphila.org>]. Each Bidder shall ascertain prior to submitting a proposal that Bidder has received all Amendments issued and shall acknowledge their receipt in their proposal submission.
2. Attached **Pre-Bid Meeting Sign-in Sheet(s), May 11th, 2023, posted on site.**
3. Attached are the **Answers and/or Clarifications to questions submitted on or before 3:00 pm Thursday, May 25th, 2023, by prospective Bidders.**
4. Remove Section **007343 Prevailing Wage Rates with an Effective date of 01/04/2023 and replace with 007343 Prevailing Wage Rates with an Effective date of 5/11/2023 attached.**
5. Contract Document Revisions: See attachment.
G101-R.1 CODE SUMMARY, GENERAL NOTES AND ABBREVIATIONS
A104-R.1 NEW WORK – ATTIC AND ROOF
A201-R.1 BUILDING ELEVATIONS – EAST
A631-R.1 ROOF DETAILS
A632-R.1 ROOF DETAILS
A902-R.1 WINDOW SCHEDULE

Bidder must acknowledge receipt of Addenda in their proposal submission.

Name of Firm: _____

Signature of Authorized Agent: _____

Date _____

Kingsessing Recreation Center – Package 1: Exterior Envelope Repairs & Improvements RFP
Questions/RFIs:

1. Is there a Budget for this project? If so, can you please provide that?

Yes, we have an internal engineer's estimate that we will use to help us assess bids

2. Reference Drawing A104-R.1

Note R7 .1 – Are the copings to be replaced with new Terra Cotta or metal?

Existing coping is limestone. The copings indicated to be replaced in full will be new limestone to match existing limestone. See also Elevations for locations, note A-C.3

Note R7.2 & R7.3 – These notes are not shown on the roof plan. What is the extent of these repairs?

Note R7.2 is typical all around and has been added to roof plan.

Note R7.4 in plan has been corrected to read R7.3. This occurs at all curved copings.

Additionally, Note R7.5 has been corrected to read R7.4

Note R.5 – This note shows up on the roof plan but is not a part of the General Notes. What does this note represent?

Note R.5 is regarding the Penetrations on the roof; the note is shown in plan and in keynotes.

If this is in regard to note R7.5, see answer in Question 2 above.

Note R7.4 which says to install new metal copings is shown on the roof plan at locations noted with the heavy dashed legend line calling for lead tee caps. Is it the intent to install lead tee caps in the mortar joints and a new metal cap?

See also corrections to numbering in Question 2.

The dashed line should be R7.3 (now corrected – see Addendum) and indicates extent of t-caps at curved coping. The dash-dot line should be R7.4 (now corrected – see Addendum No.1) and indicates extent of metal coping over existing. There are no t-caps where metal coping is shown.

There is no R7.5 and references to it have been corrected.

3. Can a field mixed mortar or another pre-blended mortar be used for the re-pointing of mortar joints in lieu of the Jahn 110 pointing mortar listed on the drawings?

Manufacturers other than Jahn (as Basis of Design) are acceptable as long as they meet all the requirements and standards.

Pre-blended mortar is required for consistency in final product.

See also requirements substitutions, Section 012500 Substitution Procedures

4. Will consideration be given to extending the bid date?

Bid date cannot be extended.

5. Will consideration be given to extending the completion time frame from 120 days due to long lead items such as the GFRC cornice?

The Exterior Building Envelope project contract duration will increase from 120 CCDs to 150 CCDs (Consecutive Calendar Days). Consideration of future extension of time due to long lead items will be addressed via the process set forth in the contract documents.

Please refer to Division 0, 00 7200 Standard Contract Requirements, Provision C General Requirements p. 14 item 25 Contract Time paragraph A thru H of the Contract.

MEMORANDUM

TO: Municipal Operating Departments and Awarding Agencies

FROM: Perritti DiVirgilio, Director, Fair Labor Standards

DATE: Effective May 11, 2023

RE: Updated Prevailing Wage Schedule for the City of Philadelphia

The Philadelphia Labor Standards Unit has issued an updated prevailing wage rate schedule for construction projects done on behalf of the City of Philadelphia. Enclosed herein you will find the two (2) decisions, which comprise the updated prevailing wage schedule. They are as the follows:

- I. Building Construction**
- II. Heavy and Highway Construction**

Please direct any questions or concerns regarding the prevailing wage rate schedule to my attention:

Philadelphia Labor Standards Unit
Municipal Services Bldg., 1st Floor Room 170C
1401 John F. Kennedy Blvd.
Philadelphia, PA 19102-1670
Telephone Numbers: (215) 686-2132
Fax Number: (215) 686-2116

Thank you for your cooperation.

**PREVAILING WAGE RATE SCHEDULE
 FOR CONSTRUCTION WORK DONE ON BEHALF OF CITY OF PHILADELPHIA
 INCLUDING REPAIR, ALTERATION, AND REMODELING WORK**

I. BUILDING CONSTRUCTION

A. Job Classification and Wage Rates

	Basic Hourly Rate	Fringe Benefits
ASBESTOS WORKER		
Journeyman	56.65	40.90
Handler Level 1	31.53	23.74
Handler Level 2	45.69	23.74
BOILERMAKER	51.27	35.30
BRICKLAYER	46.45	31.21
CARPENTER	50.75	29.46
CEMENT MASON	44.20	32.96
DRY WALL FINISHER	41.80	31.76
ELECTRICIAN	65.76	43.48
(Telecommunication Senior Tech)	63.97	31.53
(Telecommunication Tech A)	60.13	29.64
ELEVATOR CONSTRUCTOR	63.52	37.485
FOOTNOTES FOR ELEVATOR MECHANICS:		

A. PAID VACATION: Employer contributes 8% of basic hourly rate for 5 years or more of service or 6% for 6 months to 5 years of service.

B. Eight Paid Holidays (provided employee has worked 5 consecutive days before and the working day after the holiday): New Year's Day; Memorial Day; Independence Day; Labor Day; Veteran's Day; Thanksgiving Day and the Friday after Thanksgiving Day, and Christmas Day.

GLAZIER	46.68	36.62
IRONWORKER		
Structural & Ornamental	47.70	39.16
Reinforcing (Rodsetter)	47.41	33.10
Rigger & Machinery Mover	43.72	32.47
LABORER		
Journeyman Class One	35.20	26.82
Journeyman Class Two	35.30	26.82
Journeyman Class Three	35.35	26.82
Journeyman Class Four	35.50	26.82
Journeyman Class Five	35.60	26.82
Journeyman Class Six	35.34	26.82
Journeyman Class Seven	36.45	26.82
Journeyman Class Eight	36.50	26.82
Journeyman Class Nine	36.60	26.82
Journeyman Class Ten	36.75	26.82

Journeyman Class Eleven	37.00	26.82
Journeyman Class Twelve	35.57	26.82
LABORER: ASBESTOS ABATEMENT, LEAD ABATEMENT, TOXIC WASTE HANDLING, HAZARDOUS WASTE HANDLING		
MASTER ABATEMENT TECHNICIAN	36.70	27.00
LANDSCAPE LABORER		
Class I	28.15	23.83
Class II	28.15	23.83
LATHER	49.50	29.46
LINE CONSTRUCTION		
Lineman	57.93	27.80
(as of 5/30/2022)	59.17	29.00
(as of 5/29/2023)	60.48	30.25
(as of 6/03/2024)	62.07	31.36
Winch Truck Operator	40.55	24.50
(as of 5/30/2022)	41.42	25.45
(as of 5/29/2023)	42.34	26.40
(as of 6/03/2024)	43.45	27.18
Ground hand	34.76	22.60
(as of 5/30/22)	35.50	23.36
(as of 5/29/2023)	36.29	24.20
(as of 6/03/2024)	37.24	24.90
Watch/Flag Person	24.77	19.31
(as of 5/30/2022)	25.30	19.94
(as of 5/29/2023)	25.86	20.26
(as of 6/03/2024)	26.54	21.19
MARBLE SETTER	45.90	32.20
MARBLE FINISHER	38.27	29.15
MILLWRIGHT	49.83	34.53
PAINTER		
Brush & Roller	42.32	32.91
Spray, Steel, & Swing	43.57	32.91
Bridges	59.78	32.13
PILEDRIVERMAN	47.23	37.99
(as of 5/1/2023)	50.48	37.99
(as of 5/1/2024)	52.98	37.99
(as of 5/1/2025)	55.23	37.99
(as of 5/1/2026)	56.98	37.99
(Diver)	58.66	37.99
(as of 5/1/2023)	63.10	37.99
(as of 5/1/2024)	66.25	37.99
(as of 5/1/2025)	69.04	37.99
(as of 5/1/2026)	71.23	37.99
(Diver Tender)	47.23	37.99
(as of 5/1/2023)	50.48	37.99
(as of 5/1/2024)	52.98	37.99
(as of 5/1/2025)	55.23	37.99
(as of 5/1/2026)	56.98	37.99

PLASTERER	41.97	32.40
(as of 5/1/2023)	41.97	33.65
(as of 5/1/2024)	41.97	34.90
PLUMBER	64.73	37.61
POINTER, CAULKER, & CLEANER	47.75	29.95
POWER EQUIPMENT OPERATOR		
Group One	51.04	31.97
Group One A	54.05	32.85
Group Two	50.79	31.90
Group Two A	53.81	32.77
Group Three	46.71	30.69
Group Four	46.41	30.60
Group Five	44.69	30.09
Group Six	43.70	29.80

*****TOXIC/HAZARDOUS WASTE REMOVAL*****
 Add 20 percent to basic hourly rate for all classifications

ROOFER	41.48	33.87
Shingle	31.25	22.10
Slate & Tile	34.25	22.10
SHEET METAL WORKER	55.75	47.28
(Sign Makers and Hangers)	25.03	21.41
SOFT FLOOR LAYER (Resilient Floor)	52.49	29.73
SPRINKLER FITTER	62.79	31.43
STEAM FITTER	67.37	41.99
STONE MASON	45.90	32.20
Surveying and Layout		
(Chief of Party)	58.36	28.96
(Instrument Person)	50.75	28.96
(Rodman)	25.38	20.56
TERRAZZO MECHANIC	48.81	29.46
TERRAZZO FINISHER (Grinder)	42.71	27.71
TERRAZZO FINISHER (Finisher)	42.44	27.71
TILE SETTER	48.81	29.46
TILE FINISHER	38.27	29.15
TRUCK DRIVER		
Journeyman Class I	34.1075	20.1875
Journeyman Class II	34.2075	20.1875
Journeyman Class III And Low Boy	34.4575	20.1875
WALL COVERER	44.41	32.91
WELDER - Rate for craft to which, welding work is incidental.		
WINDOW TINTER	24.97	12.38

B. Job Classification Definitions: Building Construction,

1. Laborer Classifications:

Class One: Strip concrete, dismantle concrete, load, unload, handle and/or transport reinforced steel and steel mesh, carry lumber, handle miscellaneous building materials operate jack hammers, use paving breakers and other pneumatic tools, build scaffolds, perform raking, handle asphalt, perform spading and concrete pit work, perform grading, perform form pinning or shorting, perform demolition work with exception of burners, lay conduits, lay ducts, perform sheathing or lagging, lay non-metallic pipe, perform caulking.

Class Two: Power Buggies, Burners on Demolition.

Class Three: Wagon drill operator (single)

Class Four: Powderman, wagon drill operator (multiple), perform circular caissons excavations, caisson groundman, perform underpinning excavation, perform laborers' work at depth of eight (8) feet or below.

Class Five: Caisson bottom worker.

Class Six: Yard worker.

Class Seven: Trackmen, Brakemen, Groutmen, Bottom Shaft Men, All Other Men in Free Air Tunnels.

Class Eight: Caisson Foreman

Class Nine: Miner Helper, Form Setters.

Class Ten: Miners Bore Driver, Blasters, Drillers, Pneumatic Shield Operator.

Class Eleven: Welders & Burners.

Class Twelve: Mason Tenders

Landscape Laborers:

Class I: Landscape laborer

Class II: Farm tractor driver, hydro seeder, mulched nozzle worker, backhoe operator, bulldozer crawler type loader, tree crane operator.

Laborer - Lather and Plasterer: Wheel and/or hod carry any lather and plaster materials used by lathering and plastering contractors' build scaffolds; build runways; perform clean-up and removal of debris as covered by lathering and plastering contractor's contract; deliver any material used by lathering and plastering contractor, from curbside to building and back, unless motor vehicles are permitted to enter building with required materials; all mortar designated for use by plasterer shall be carried via wheel barrow or hod; all plastering and fire proofing machines, as well as guns and mixers requiring the assistance of a worker other than plasterer operator, shall be manned by helper (tender).

2. Truck driver classifications:

Class I: Helper, stake body truck operator (single axle, dumpster).

Class II: Dump truck operator, tandem truck operator, batch truck operator, semi-trailer truck operator, agitator-mixer truck operator, dump Crete type vehicle operator, asphalt distributor, farm tractor operator (when tractor used to transport materials), stake body truck (tandem) operator.

Class III: Euclid type; off highway equipment back truck operator; belly dump truck operator; double-hitched equipment trailer operator; straddle carrier (Ross) operator; low-bed trailer truck operator.

3. Power Equipment Operator Classifications – Building

Group One:

Handling steel and stone in connection with erection Cranes doing hook work

Any machines handling machinery

Helicopters

Concrete Pumps (building)

Machines similar to above, including remote control equipment

Group One A:

Handling steel and stone in connection with erection.

Cranes doing hook work

Any machines handling machinery

Concrete Pumps (Building)

High Rail/Burro Crane

Rail Loader (Winch Boom Type)

All equipment in this group which previously received the hour in lieu of an oiler will receive Wage Group I (A). Equipment in this Wage Group that does not require an oiler.

Machines similar to above, including remote control equipment

Group Two:

All types of cranes

All types of backhoes

Cableways

Draglines

Keystones

All types of shovels

Derricks

Pavers 21E and over

Trenching machines

Trench shovels

Cable spinning machine

Gradalls

Front- end Loaders

Boat Captain

Hoist with Two Towers

Building Hoists-double drum (unless used as a single drum)

Pippin type backhoes

Tandem scrapers

Tower type crane operation erecting dismantling jumping or jacking

Drills self-contained (Drillmaster type)

Fork lift (20ft. and over)

Motor Patrols (fine grade)

Batch Plant with Mixer

Carryalls, Scrapers, Tournapulls

Roller (High Grade Finishing)

Spreaders (Asphalt)

Bulldozers and Tractors

Mechanic-Welder

Conveyor Loaders (Euclid-Type Wheel)

Concrete Pumps (Heavy Highway)

Milling Machine

Bobcat

Side Boom

Directional Boring Machines

Vermeer Saw Type Machine (other than hand held)

Tractor Mounted Hydro Axe

Chipper with boom

All Autograde and concrete finishing machines
Bundle Pullers/Extractors (Tubular)

Machines similar to the above including remote control equipment

*Surcharge

Group Two (A):

Crawler backhoes and Crawler gradalls over one (1) cubic yard factory rating
Hydraulic backhoes over one (1) cubic yard factory rating
Single person operation truck cranes 15 ton and over factory rating
Cherry picker type machinery and equipment 15 ton and over factory rating, etc.

Cranes doing hook work will be paid Wage Group I (A).

All equipment in this Group which previously received the hour in lieu of an oiler will receive Wage Group II (A) including concrete pumps (Heavy/Highway).

Machines similar to the above including remote control equipment

*Surcharge

Group Three:

Asphalt Plant Engineers
Conveyors (except building conveyors)
Well Driller
Forklift Trucks of all types
Ditch Witch (small trenchers)
Motor Patrols
Fine Grade machines
Rollers
Concrete Breaking Machines (Guillotine Only)
Stump Grinder
High or Low Pressure Boilers
Building Hoist (single drum)
Elevator Operator (New Construction)

Machines similar to above including remote control equipment

Group Four:

Seamen Pulverizing Mixer
Form Line Graders
Farm Tractors
Road Finishing Machines
Concrete Spreaders (Heavy Highway)
Power Broom (self-contained)
Seed Spreader
Grease Truck

Machines similar to the above including remote control equipment

Group Five:

Compressors
Pumps
Well pint pumps
Conveyors (Building)
Welding Machines
Heaters
Tireman, Power Equipment
Maintenance Engineers (Power Boats)
Miscellaneous Equipment
Operator

Elevator Operator (Renovations)
House Car
Machines similar to above including remote control equipment
Group Six:
Fireman
Oilers and Deck Hands (Personnel Boats)/Grease Truck Helpers
*Surcharge
Group Seven (A):
Handling steel and stone in connection with erection
Cranes doing hook work
Any machines handling machinery
Cable spinning machine
Helicopters
Concrete pumps (Building)
High Rail/Burro Crane
Rail Loader (Winch Boom Type)
Machines similar to above, including remote control equipment
Group Seven B
All types of cranes
All types of backhoes
Cableways
Conveyor Loader (Euclid-Type Wheel)
Drag Lines
Keystones
All types of shovels
Derricks
Pavers 21E and over
Trench shovels
Trenching machines
Gradalls
Front-end Loaders
Boat Captain
Hoist with two towers
Concrete Pumps (Heavy, Highway)
Building Hoists-double drum (unless used as a single drum)
Milling Machine
Mucking Machines in Tunnel
Pippin type backhoes
Bobcat
Tandem scrapers
Side Boom
Tower type crane—operation, erecting, dismantling,
Jumping or jacking
Directional Boring Machines
Vermeer Saw Type Machine (other than hand held)
Drills self-contained (Drillmaster type)
Fork Lift (20 ft. & over)
Track or Mounted Hydro Axe
Motor Patrols (Fine Grade)

Chipper with boom
Batch Plant with Mixer
All autograde and concrete finishing machines
Caryalls, Scapers & Tournapulls
Rollers (High Grade Finishing)
Bundle Pullers/Extractors (Tubular)
Spreaders (Asphalt)
Bulldozers and Tractors
Mechanic – Welders
Production Switch Tamper
Ballast Regulators
Tie Replacer
Rail/Road Loader
Power Jack liner
Machines similar to above, including remote control equipment

II. HEAVY AND HIGHWAY CONSTRUCTION

A. JOB CLASSIFICATION AND WAGE RATES

	Basic Hourly Rate	Fringe Benefits
BOILERMAKER	51.27	35.30
CARPENTER	52.79	29.06
(as of 5/1/2023)	54.99	29.06
(as of 5/1/2024)	56.69	29.06
(as of 5/1/2025)	58.49	29.06
(as of 5/1/2026)	60.19	29.06
CEMENT MASON	43.20	32.91
(as of 5/1/2024)	44.25	33.41
(as of 5/1/2025)	45.80	33.41
(as of 5/1/2026)	47.40	33.41
ELECTRICIAN	65.76	43.48
IRONWORKERS		
Structural & Ornamental	47.70	39.16
Reinforcing (Rodsetter)	47.41	33.10
Rigger & Machinery Mover	43.72	32.47
LABORERS		
Group One	36.30	27.20
Group Two	36.50	27.20
Group Three	36.50	27.20
Group Four	31.10	27.20
Group Five	37.15	27.20
Group Six	37.20	27.20
Group Seven	37.05	27.20
Group Eight	36.80	27.20
Group Nine	36.65	27.20
Group Ten	36.80	27.20
Group Eleven	36.70	27.20
Group Twelve	38.40	27.20
Group Thirteen	40.43	27.20
Group Fourteen	36.55	27.20
LANDSCAPING LABORER		
Class I	27.73	23.65
Class II	27.73	23.65
LINE CONSTRUCTION		
Lineman	57.93	27.80
(as of 5/30/2022)	59.17	29.00
(as of 5/29/2023)	60.48	30.25
(as of 6/03/2024)	62.07	31.36
Winch Truck Operator	40.55	24.50
(as of 5/30/2022)	41.42	25.45
(as of 5/29/2023)	42.34	26.40
(as of 6/03/2024)	43.45	27.18

Ground hand	34.76	22.60
(as of 5/30/22)	35.50	23.36
(as of 5/29/2023)	36.29	24.20
(as of 6/03/2024)	37.24	24.90
Watch/Flag Person	24.77	19.31
(as of 5/30/2022)	25.30	19.94
(as of 5/29/2023)	25.86	20.26
(as of 6/03/2024)	26.54	21.19
MILLWRIGHT	49.83	34.53
PAINTERS		
Brush & Roller	42.32	32.91
Spray, Steel, & Swing	43.57	32.91
Bridges	59.78	32.13
PILEDRIVERMAN	47.23	37.99
(as of 5/1/2023)	50.48	37.99
(as of 5/1/2024)	52.98	37.99
(as of 5/1/2025)	55.23	37.99
(as of 5/1/2026)	56.98	37.99
(Diver)	58.66	37.99
(as of 5/1/2023)	63.10	37.99
(as of 5/1/2024)	66.25	37.99
(as of 5/1/2025)	69.04	37.99
(as of 5/1/2026)	71.23	37.99
(Diver Tender)	47.23	37.99
(as of 5/1/2023)	50.48	37.99
(as of 5/1/2024)	52.98	37.99
(as of 5/1/2025)	55.23	37.99
(as of 5/1/2026)	56.98	37.99
POWER EQUIPMENT OPERATOR		
Group One	51.04	31.97
Group One A	54.05	32.85
Group Two	50.79	31.90
Group Two A	53.81	32.77
Group Three	46.71	30.69
Group Four	46.41	30.60
Group Five	44.69	30.09
Group Six	43.70	29.80

*****TOXIC/HAZARDOUS WASTE REMOVAL*****

Add 20 percent to basic hourly rate for all classifications

POWER EQUIPMENT OPERATOR DREDGER		
Class A1	42.66	14.01
Class A2	38.02	13.73
Class B1	36.89	13.66
Class B2	34.73	13.53
Class C1	33.78	13.18
Class C2	32.69	13.11
Class D	27.16	12.58

STEAM FITTER	67.37	41.99
STONE MASON	44.90	30.75
Surveying and Layout		
(Chief of Party)	60.71	29.06
(as of 5/1/2023)	63.24	29.06
(as of 5/1/2024)	65.19	29.06
(as of 5/1/2025)	67.15	29.06
(as of 5/1/2026)	69.10	29.06
(Instrument Person)	52.79	29.06
(as of 5/1/2023)	54.99	29.06
(as of 5/1/2024)	56.69	29.06
(as of 5/1/2025)	58.39	29.06
(as of 5/1/2026)	60.09	29.06
(Rodman)	42.23	22.41
(as of 5/1/2023)	43.99	22.41
(as of 5/1/2024)	45.35	22.41
(as of 5/1/2025)	46.71	22.41
(as of 5/1/2026)	48.07	22.41
TRUCK DRIVER		
Class I	34.1075	20.1875
Class II	34.2075	20.1875
Class III	34.4575	20.1875

B. Job Classification Definitions: Heavy and Highway Construction

1. Laborer Classifications:

Group One: Yard workers: (laborer, scale mixerman, burnerman, dustman, feeder)

Group Two: General laborer; Asphalt Shovelers; Sheeting, Shoring & Lagging – Laborer; Stone, Granite & Artificial Stone Setting Laborer; Hod Carriers; Scaffold Building; Relief Joint & Approach Slabs; Assembling & Placing Gabions; Pneumatic Tool Laborers; Concrete Forms & Stripping Laborers; Concrete Lumber Material Laborers; Steel & Steel Mesh (carrying & handling); Form Pinners; Mortar Mixers; Pouring & Placing Concrete; Grade Men.

Group Three: Vibrator Laborers; Finish Surface Asphalt Rackers; Jackhammer Operators; Paving Breaker Operator; Pipelayer & Caulker (all joints up to within 5 feet of the Building Foundation Line); Conduit & Duct Layers

Group Four: Flagperson

Group Five: Miners

Group Six: Welders and Burners.

Group Seven: Miner Bore Driver; Blasters; Drillers Pneumatic Shield Operator

Group Eight: Form Setters

Group Nine: Trackmen; Brackmen; Groutmen; Bottom Shaft Men; All other Laborers in Free Air Tunnels; Underpinning (When an underpinning excavation for a pier hole of five feet square or less and eight feet or more deep is dug, the rate shall apply only after a depth of eight feet is reached, to the men working in the bottom)

Group Ten: Circular Caissons (Where an excavation for circular caissons are dug eight feet or more below the natural grade level adjacent to the starting point of the caisson hole, at ground level, for the men working in the bottom); Welders, Burners & Air Tuggers

Group Eleven: Powdermen; Multiple Wagon Drill Operator Laborer

Group Twelve: Caisson Laborer Foreman

Group Thirteen: Toxic/Hazardous waste Handler

Group Fourteen: Wagon Drill/Hydraulic Track Drill Operator Laborer

Landscape Laborers:

Class I: Landscape laborer

Class II: Farm tractor driver, hydroseeder, mulcher nozzle worker, backhoe operator, bulldozer crawler type loader, tree crane operator.

2. **Power Equipment Operator Classifications - Heavy, & Highway**

Group One:

Handling steel and stone in connection with erection Cranes doing hook work

Any machines handling machinery

Cable spinning machine

Helicopters

Concrete Pumps (building)

Machines similar to above including remote control equipment

Group One A:

Handling steel and stone in connection with erection.

Cranes doing hook work

Any machines handling machinery

Concrete Pumps (Building)

High Rail/Burro Crane

Rail Loader (Winch Boom Type)

All equipment in this group which previously received the hour in lieu of an oiler will receive Wage Group I (A). Equipment in this Wage Group that does not require an oiler.

Machines similar to above, including remote control equipment

Group Two:

All types of cranes

All types of backhoes

Draglines

Keystones

All types of shovels

Derricks

Pavers 21E and over

Trenching machines

Trench shovels

Gradalls

Front- end Loaders

Boat Captain

Hoist with Two Towers

Building Hoists-double drum (unless used as a single drum)

Pippin type backhoes

Tandem scrapers

Tower type crane operation erecting dismantling jumping or jacking

Drills self-contained (Drillmaster type)

Fork lift (20ft. and over)

Motor Patrols (fine grade)

Batch Plant with Mixer

Carryalls, Scrapers, Tournapulls

Roller (High Grade Finishing)

Bulldozers and Tractors

Mechanic-Welder
Conveyor Loaders (Euclid-Type Wheel)
Concrete Pumps (Heavy Highway)
Milling Machine
Bobcat
Side Boom
Directional Boring Machines
Vermeer Saw Type Machine (other than hand held)
Tractor Mounted Hydro Axe
Chipper with boom
All Autograde and concrete finishing machines
Bundle Pullers/Extractors (Tubular)

Machines similar to the above including remote control equipment

Group Two A:

Crawler backhoes and Crawler gradalls over one (1) cubic yard factory rating
Hydraulic backhoes over one (1) cubic yard factory rating
Single person operation truck cranes 15 ton and over factory rating
Cherry picker type machinery and equipment 15 ton and over factory rating, etc.
Cranes doing hook work will be paid Wage Group I (A).
All equipment in this Group which previously received the hour in lieu of an oiler will receive Wage Group II (A) including concrete pumps (Heavy/Highway).

Machines similar to the above including remote control equipment

Group Three:

Asphalt Plant Engineers
Conveyors (except building conveyors)
Well Drillers
Forklift Trucks of all types
Ditch Witch (small trenchers)
Motor Patrols
Fine Grade machines
Rollers
Concrete Breaking Machines (Guillotine Only)
Stump Grinder
High or Low Pressure Boilers
Building Hoist (single drum)
Elevator Operator (New Construction)

Machines similar to above including remote control equipment

Group Four:

Seamen Pulverizing Mixer
Form Line Graders
Farm Tractors
Road Finishing Machines
Concrete Spreaders (Heavy Highway)
Power Broom (self-contained)
Seed Spreader
Grease Truck

Machines similar to the above including remote control equipment

Group Five:

Compressors/Pumps
Well pint pumps

Conveyors (Building)
Welding Machines
Heaters
Tireman, Power Equipment
Maintenance Engineers (Power Boats)
Miscellaneous Equipment Operator
Elevator Operator (Renovations)
House Car
Machines similar to above including remote control equipment

Group Six:

Fireman
Oilers and Deck Hands (Personnel Boats)
Grease Truck Helpers

Group Seven A:

Handling steel and stone in connection with erection
Cranes doing hook work
Any machines handling machinery
Cable spinning machinery
Helicopters
Concrete pumps (Building)
High Rail/Burro Crane
Rail Loader (Winch Boom Type)

Machines similar to above, including remote control equipment

Group Seven B:

All types of cranes
All types of backhoes
Cableways
Conveyor Loader (Euclid-Type Wheel)
Drag Lines
Keystones
All types of shovels
Derricks
Pavers 21E and over
Trench shovels
Trenching machines
Gradalls
Front-end Loaders
Boat Captain
Hoist with two towers
Concrete Pumps (Heavy, Highway)
Building Hoists-double drum (unless used as a single drum)
Milling Machine
Mucking Machines in Tunnel
Pippin type backhoes
Bobcat
Tandem scrapers
Side Boom
Tower type crane operation, erecting, dismantling,
Jumping or jacking
Directional Boring Machines

Vermeer Saw Type Machine (other than hand held)
Drills self-contained (Drillmaster type)
Fork Lift (20 ft & over)
Tractor Mounted Hydro Axe
Motor Patrols (Fine Grade)
Chipper with boom
Batch Plant with Mixer
All autograde and concrete finishing machines
Carryalls, Scapers & Tournapulls
Rollers (High Grade Finishing)
Bundle Pullers/Extractors (Tubular)
Spreaders (Asphalt)
Bulldozers and Tractors
Mechanic – Welders
Production Switch Tamper
Ballast Regulators
Tie Replacer
Rail/Road Loader
Power Jack liner
Machines similar to above, including remote control equipment

*Surcharge

Power Equipment Operator Dredger Classifications

Class A: Lead Dredgeman, Operator, Leverman, Licensed Tug Operator over 1000HP.

Class A1: Dozer Operator, Front-end Loader.

Class B1: Derrick Operator, Spider/Spill Barge Operator, Engineer, Electrician, Chief welder Chief Mate, Fill Placer, Operator 2, Maintenance Engineer, Licensed Boat Operator.

Class B2: Certified Welder.

Class C1: Mate, Drag Barge Operator, Steward, Assistant Fill Placer, Welder.

Class C2: Boat Operator.

Class D: Shoreman, Deckhand, Rodman, Scowman, Cook, Messman, Porter/Janitor, Oiler.

3. Truck Driver Classifications:

Class I: Helper, stake body truck operator (single axle, dumpster)

Class II: Dump truck operator, tandem truck operator, batch truck operator, semi-trailer truck operator, agitator-mixer truck operator, dumpcrete type vehicle operator, asphalt distributor, farm tractor operator (when used to transport materials), stake body truck (tandem) operator.

Class III: Euclid type, off highway equipment back truck operator, belly dump truck operator, double-hitched equipment trailer operator, straddle carrier (Ross) operator; lowbed trailer truck operator.

NOTE:

1. Contractors are advised to contact the Philadelphia Labor Standards Unit with any questions regarding job classification, prevailing wage rates, and fringe benefits.
2. Prior to employing apprentices on a public works project, the contractor is required to provide written evidence of employee's registration with a statewide training program recognized by the U.S. Bureau of Apprenticeship and Training (BAT). Contractors shall forward proper documentation for each bona fide apprentice to:

**Philadelphia Labor Standards Unit
Municipal Services Building
1401 John F. Kennedy Boulevard – 1st Floor, Room 170C
Philadelphia, PA 19102-1670
Telephone Number: (215) 686-2132
Fax Number: (215) 686-2116**



KELLY MAIELLO ARCHITECTS
1420 Walnut Street, 15th Floor
Philadelphia, PA 19102
www.kmarchitects.com

ADDENDUM NO. 1

PROJECT: KINGSESSING REC CENTER BUILDING AND
SITE IMPROVEMENTS PACKAGE 1:
EXTERIOR ENVELOPE REPAIRS AND
IMPROVEMENTS

DATE OF ISSUANCE: 5/19/2023

OWNER: Rebuild Philadelphia / Philadelphia Parks and
Recreation

These drawings, specifications and instructions form a part of and modify the Drawings, Specifications, and Instructions issued for Packages to the extent noted herein:

Careful note of these Drawings, Specifications, and Instructions shall be taken by all parties of interest so that proper allowance is made in all computations, estimates, and contracts so that all trades affected are fully advised in the performance of Work that will be required of them.

These Drawings, Specifications, and Instructions supersede all previous Drawings, Specifications, and Instructions pertaining to these items.

All Drawings, Specifications and Instructions not reissued as part of Addendum No. 1 dated 19 May 2023 remain valid.

DRAWINGS:

G101-R.1	CODE SUMMARY, GENERAL NOTES AND ABBREVIATIONS	ADD: Energy code compliance summary
A104-R.1	NEW WORK – ATTIC AND ROOF	REV: Clarifications to the roof plan keynotes regarding which part of the parapet gets T-caps and which part gets full metal coping. Bubbled portion is typical for all keynotes in plan: Note R7.5 changed to R7.4 Note R7.4 changed to R7.3 R7.3 added to plan List of keynotes did not change.
A201-R.1	BUILDING ELEVATIONS – EAST	Proposed decorative light fixtures (Ref. Note A-L.2) at either side of main entry removed from project scope. Note A-L.3 changed to A-L.2 (Upwash light fixtures) Added note at Lighting Keynote – “For reference only - light fixtures to be furnished and provided in Package 2”. And A-L.2 also at metal panels.
A631-R.1	ROOF DETAILS	REV: Detail 5 & 6 change metal gutter liner to self adhered on ¼” HD cover board.
A632-R.1	ROOF DETAILS	REV: Existing dormers- trim corrected to better reflect existing profile. New dormers - metal cornice profile simplified. Louvers redesigned to have vertical mullions to match window type A-1 (existing window configuration).

A902-R.1	WINDOW SCHEDULE	REV: Louver elevations edited to reflect vertical mullions to match window type A-1 (existing window configuration).

SPECIFICATIONS:

NO.	SECTION NAME	
<p>The following modifies the built in gutter detail substrate and reglet counterflashing configuration. The detail is based on the Siplast ParaPro (PMMA) liquid flashing gutter liner system. See also Dwg A631-R.1</p>		
07 5200	SBS MODIFIED BITUMINOUS MEMBRANE ROOFING	<p>Section 1.10 WARRANTY</p> <p>Paragraph C. Provide twenty (20) year manufacturer's material and labor warranty to cover failure to prevent penetration of water.</p> <p>Add Paragraph: "Provide ten (10) year manufacturer's material warranty to cover failure to prevent penetration of water."</p> <p>Delete: "and labor"</p>
07 5200	SBS MODIFIED BITUMINOUS MEMBRANE ROOFING	<p>Section 2.03 MEMBRANE AND SHEET MATERIALS</p> <p>Add new paragraph C: "Pro Base SA: installed over cover board in upper gutter."</p>
07 5200	SBS MODIFIED BITUMINOUS MEMBRANE ROOFING	<p>Section 3.04 BUILT-IN GUTTER</p> <p>Add Paragraph A:</p> <p>"Upper roof gutter assembly: Install Pro Base SA self-adhesive bituminous ply directly over HD gypsum cover board. Roll seams and field with steel roller to assure adhesion.</p> <p>Install liquid flashing system according to manufacturer's recommendations. Extend liquid flashing not less than 3 inches (76 mm) in all directions onto sheet metal scuppers, valleys, pipe flashings, and related flashing interfaces."</p>
07 6200	SHEET METAL FLASHING AND TRIM	<p>Section 1.01 SECTION INCLUDES</p> <p>Paragraph B. "20- gauge galvanized steel built-in gutter liner."</p> <p>Delete paragraph in its entirety</p>
07 6200	SHEET METAL FLASHING AND TRIM	Section 2.01 MANUFACTURERS

ABBREVIATIONS

ABV	Above	EA	Each	LAM	Laminated	R	Railus, Riser, Rubber
AFF	Above Finish Floor	E	East	LAT	Lateral	RECD	Received
A P	Access Panel	E.O.S.	Edge of Slab	LAV	Lavatory	RECP	Receptacle
ACOUS	Acoustical	ELEC	Electric, Electrical	LB	Pound	REF	Reference
ACT	Acoustic Ceiling Tile	EW	Electric Water Cooler	LH	Left Hand	REFR	Refrigerate, Refrigerator
AD	Acrylic Diffuser	EL	Elevation	LT	Light	REG	Register
AGOR	Aggregate	ELEV	Elevator	LWC	Light Weight Concrete	REFC	Recessed Fire Extinguisher Cabinet
ALLOW	Allowance	ENG	Engineering	LTC	Lighting	REHF	Reinforced
ALT	Alternate	ENG	Engineering	LIN	Linear	RPP	Reinforced Plastic Paneling
AL, ALUM	Aluminum	EQ	Equal	LF	Linear Feet	REQD	Required
ANOD	Anodized	EQUIP	Equipment	RET	Returned	RET	Return
ARCH	Architectural	EXH	Exhaust	UNO	Unidirectional	RA	Return Air
A D	Area Drain	EXIST, EXTG	Existing	LVR	Low Point	REV	Revision
ASPH	Asphalt	EJ	Expansion Joint	LPT	Low Point	RH	Right Hand
AVG	Average	EXT	Exterior	MGR	Manager	R.D.	Root Drain
B	Base	FOW	Face of Wall	MAN	Manual	RM	Room
BSMT	Basement	FT	Figure	MFG	Manufacturer	RO	Rough Opening
BRG	Bearing	FIN	Finish	M.O.	Masonry Opening	SAN	Sanitary
BET	Between	FEC	Fer Extinguisher Cabinet	MATL, MATL	Material	SND	Sanitary Napkin Dispenser
BIT	Bituminous	FHC	Fire Hose Cabinet	MAX	Maximum	SCH	Schedule
BLK	Block	FP	Fireproof(ing)	MECH	Mechanical	SLD	Sealed
BLDG	Building	FLAM	Flammable	SECT	Section	SH	Sheet
BD	Board	FLR	Floor	MEMB	Membrane	SHT	Sheet
BOT	Bottom	FD	Floor Drain	MTL	Metal	SIM	Similar
BTU	British Thermal Units	FLRG	Flooring	MEZZ	Mezzanine	SK	Sketch
BLDG	Building	FLOUR	Fluorescent	MIN	Minimum	SLT	Slate
BUR	Bulk-up Roofing	FTG	Footing	MISC	Miscellaneous	STC	Sound Transmission Coefficient
BSD	Bulletin Board	FDN	Foundation	MTD	Mounted	S	South
BO	By Others					SPKR	Speaker
CAB	Cabinet	GALV	Galvanize	NOM	Nominal	SPEC	Specification
CR	Card Reader	GA	Gauge	N	North	SQ	Square
CPT	Carpet	GEN	Generator	NC	Not in Contract	SS	Stainless Steel
CLG	Ceiling	GL	Glass	NTS	Not to Scale	STND	Standard
CTR	Center	GL COAT	Glass Coating	NO	Number	STL	Steel
CL	Centerline	GYP	Gypsum	OFF	Office	STR, STRUC	Structural
C to C, C-C	Center to Center	GWB	Gypsum Wall Board	OC	On Center	SMPFC	Surface Mounted FEC
CSR	Ceramic	HDR	Handrail	OPG	Opening	SUSP	Suspend, Suspended
CT	Ceramic Tile	HNDR	Handrail	OPP	Opposite	TEL	Telephone
CHAM	Chamber	HDW	Hardware	OC	On Center	TEMP	Tempered
CH	Circle	OD	Over-all	OD	Outside Diameter	THK	Thick
CLR	Clear	HVAC	Heating, Ventilating & Air Conditioning	OVHD	Overhead	THRU	Through
CLO	Close	HT	Height	OSD	Overhead Bifold Door	T&G	Tounge and Groove
CW	Cold Water	HSJ	Hollow Metal	OSD	Overhead Ceiling Door	T&B	Top and Bottom
COL	Column	HOR, HORIZ	Horizontal	OCG	Overhead Ceiling Grille	TOS	Top of Steel, Top of Slab
CONC	Concrete	HDS	Hot Dip Galvanized	PT	Paint	TYP	Typical
CMU	Concrete Masonry Unit	HW	Hot Water	PTD	Painted	UL	Underwriters' Laboratories, Inc.
CONST	Construction	IN	Inch	PR	Par	VP	Vapor Barrier, Vinyl Base
CU	Construction Joint	INCL	Include	PRL	Panel	VB	Verify in Field
CONT	Continue or Continuous	INFO	Information	PKG	Partition	VERT	Vertical
CONTR	Contractor	ID	Inside Diameter	PTN	Partition	V	Vinyl
CG	Corner Guard	INSUL	Insulate	PERP	Perpendicular	VCT	Vinyl Composition Tile
CORR	Corrosion	INT	Interior	PLM	Plastic Laminate	W	Water
CU FT	Cubic Feet	JAN	Janitor's Closet	PLYWD	Plywood	WC	Watercloset
CFM	Cubic Feet per Minute	JB	Joint	PVC	Polyvinyl Chloride	WP	Waterproofing
DEG	Degree	JT	Joint	PWF	Pounds per sq. ft.	WF	Wood
DEMO	Demolition, Demolish	JN	Janition Box	PSI	Pounds per sq. in.	WO	Without
DTL	Detail	KD	Knock Down	PREFAB	Prefabricated	W/O	With
DIA	Diameter	KIT	Kitchen	PROJ	Project, Projection	W/O	Without
DIM	Dimension	KO	Knock Out	QTY	Quantity		
DW	Dishwasher			QT	Quarry Tile		
DISP	Dispenser						
DR	Door						
DBL	Double						
DN	Down						
DR	Drain						
DWG	Drawing						

GENERAL NOTES:

- REFERENCE EXTERIOR BUILDING ELEVATIONS AND WINDOW SCHEDULE FOR NEW WORK AT WINDOWS.
- REFERENCE BUILDING ELEVATIONS FOR EXTENT OF EXTERIOR DOOR AND FACADE SCOPE.
- THE CONTRACTOR SHALL INVESTIGATE JOB SITE TO COMPARE CONTRACT DOCUMENTS AND EXISTING CONDITIONS. INCLUDE COST FOR ALL WORK DESCRIBED IN CONTRACT DOCUMENTS AND REQUIRED OR IMPLIED BY EXISTING CONDITIONS. NOTIFY ARCHITECT OF ANY OMISSIONS OR CONFLICTS IN THE DRAWINGS AND ANY RESTRICTIONS RELATED TO THE EXECUTION OF THE WORK.
- THE CONTRACTOR SHALL COMPLY AND COORDINATE ALL WORK WITH BUILDING OWNER REGARDING HEAT, WATER, ELECTRICITY, DELIVERIES, ACCESS, NOISE CONTROL, TRASH AND DEBRIS REMOVAL, HOISTING, AND ANY OTHER UTILITIES OR OWNERS RULES AND REGULATIONS CONCERNING THE PROJECT SITE.
- THE CONTRACTOR SHALL COORDINATE SCHEDULING, PROVISIONS FOR INSTALLATION, LOCATIONS AND THE ACTUAL INSTALLATION OF ITEMS FURNISHED BY OWNER OR BY OTHERS.
- THE CONTRACTOR SHALL VERIFY ALL DIMENSIONS IN THE FIELD AND IS RESPONSIBLE FOR ALL PHASES INCLUDING BIDDING, FABRICATION, COORDINATION AND CONSTRUCTION. CONTRACT DRAWINGS ARE NOT INTENDED TO REPRESENT EXACT DIMENSIONS.
- DO NOT SCALE DRAWINGS. DIMENSIONS GOVERN. LARGE SCALE DETAILS GOVERN OVER SMALL SCALE DETAILS.
- CHANGES IN DRAWINGS OR ACTUAL WORK MUST BE ISSUED BY THE ARCHITECT.
- PERFORM ALL WORK AND INSTALL MATERIALS IN STRICT ACCORDANCE WITH MANUFACTURER'S SPECIFICATIONS AND INSTRUCTIONS AND IN A MANNER CONSISTENT WITH INDUSTRY STANDARD OF WORKMANSHIP.
- THE CONTRACTOR SHALL EXAMINE ALL SURFACES OR ELEMENTS TO DETERMINE THAT THEY ARE SOUND, DRY, CLEAN AND READY TO RECEIVE FINISHES PRIOR TO INSTALLATION. START OF INSTALLATION SHALL IMPLY ACCEPTANCE OF SUBSTRATE AND SHALL NOT BE GROUNDS FOR CLAIMS AGAINST IMPROPER PERFORMANCE OF INSTALLED MATERIALS. ADVISE ARCHITECT OF ANY EXISTING CONSTRUCTION NOT LEVEL, SMOOTH AND PLUMB WITH INDUSTRY STANDARDS PRIOR TO START OF CONSTRUCTION.
- THE CONTRACTOR SHALL INSTALL AND MAINTAIN ALL NECESSARY COVERINGS, PROTECTIVE ENCLOSURES, TEMPORARY DOORS AND PARTITIONS AND DUST BARRIERS TO PROTECT ALL OCCUPANTS AND EXISTING WORK AND FINISHES TO REMAIN. LOCATION OF SUCH PROTECTION SHALL BE VERIFIED WITH OWNER AND LOCAL CODE OFFICIALS FOR EGRESS CONFORMANCE. PRIOR TO COMMENCING WORK AND IN COORDINATION WITH PROGRESSION OF WORK SCHEDULE, PERFORM WORK IN A MANNER THAT WILL AVOID HAZARDS TO PERSONS IN ADJACENT AREAS AND THAT WON'T INTERFERE WITH WORK OR PASSAGE TO ANY OF THESE AREAS. REPAIR AND REPLACE ANY DAMAGES CAUSED BY IMPROPER PROTECTIONS AT NO ADDITIONAL CHARGE TO OWNER.
- WORK DAMAGED DURING CONSTRUCTION OR NOT CONFORMING TO SPECIFIED STANDARDS, TOLERANCES OR MANUFACTURER'S INSTRUCTIONS FOR INSTALLATION SHALL BE REPLACED, BY THE CONTRACTOR, AT NO ADDITIONAL CHARGE TO THE OWNER.
- THE CONTRACTOR SHALL MAINTAIN ALL EXITS, EXIT LIGHTING, FIRE PROTECTION DEVICES AND LIFE SAFETY SYSTEMS IN WORKING ORDER. CONTRACTOR TO PROVIDE TEMPORARY FIRE EXTINGUISHERS DURING THE COURSE OF CONSTRUCTION AS REQ'D BY THE AUTHORITIES HAVING JURISDICTION.
- EXIT DOORS, EGRESS DOORS, AND OTHER DOORS REQUIRED FOR MEANS OF EGRESS SHALL BE OPERABLE FROM THE INTERIOR WITHOUT USE OF A KEY OR SPECIAL KNOWLEDGE OR EFFORT.
- CONTRACTOR SHALL FULLY ACQUANT HIMSELF WITH THE CONDITIONS OF THE CONTRACT, LOCAL CONDITIONS RELATING TO LOCATION, ACCESSIBILITY AND GENERAL CHARACTER OF THE CONSTRUCTION SITE AND LOCAL LABOR CONDITIONS SO THAT HE UNDERSTANDS THE NATURE, EXTENT, DIFFICULTIES, AND RESTRICTIONS RELATED TO THE EXECUTION OF WORK. NOTIFY ARCHITECT OF ALL DISCREPANCIES PRIOR TO COMMENCING WORK.
- ALL WOOD BLOCKING IN FIRE RATED ASSEMBLIES TO BE FIRE RETARDANT.
- ALL WOOD ON EXTERIOR WALLS AND ROOF TO BE MOISTURE RESISTANT.
- ALL WOOD BLOCKING EXTERIOR WALLS, WINDOWS, AND PARAPET TO BE FIRE RETARDANT.
- ALL PENETRATIONS THROUGH FIRE OR SMOKE RATED WALLS ARE TO BE SEALED TO MAINTAIN INTEGRITY OF WALL CONSTRUCTION AND RATING (ASTM E814 SYSTEM BY 3M, HLLI, OR SIM).
- CONTRACTOR TO REMOVE ANY STRAY PAINT, DIRT, OR STAINS INCURRED DURING THE CONSTRUCTION PROCESS. CONTRACTOR SHALL BE RESPONSIBLE FOR REMOVING ALL TEMPORARY EQUIPMENT COVERINGS USED DURING CONSTRUCTION AND HE SHALL ALSO BE RESPONSIBLE FOR REMOVING HIS TRASH OFF OF THE JOB SITE DAILY.
- THE CONTRACTOR SHALL PERFORM ALL CUTTING AND WELDING IN COMPLIANCE WITH THE PUBLISHED STANDARDS OF NFPA. THE CONTRACTOR SHALL PROVIDE FIRE WATCHES FOR ALL CUTTING, GRINDING, AND WELDING OPERATIONS. THE TRAINING OF THESE FIRE WATCHES AND THE USE OF THE CONTRACTOR'S SUPPLIED FIRE EXTINGUISHERS IS THE RESPONSIBILITY OF THE CONTRACTOR.
- WHERE TWO DISSIMILAR METALS MEET, PAINT FACE OF ONE WITH BITUMINOUS PAINT.
- ALL EXTERIOR DOORS AND FRAMES TO RECEIVE PERIMETER WEATHER STRIPPING AS PER SPECIFICATIONS.
- ANY AREA OUTSIDE THE LIMITS OF CONSTRUCTION DISTURBED BY OPERATIONS OF THE CONTRACTOR SHALL BE RESTORED AT THE CONTRACTORS EXPENSE.
- ALL CONCRETE WALKS, ASPHALT, CURBS AND LANDSCAPING DAMAGED DURING CONSTRUCTION ARE TO BE REPAIRED BY CONTRACTOR AT NO ADDITIONAL COST TO THE OWNER.
- ALL EXTERIOR WINDOWS, DOORS, AND ALL OTHER PENETRATIONS THRU EXTERIOR WALLS SHALL BE SEALED AROUND ENTIRE PERIMETER WITH SEALANT. (BOTH ON EXTERIOR AND INTERIOR SIDES)
- ALL DIMENSIONS ARE TO FACE OF FINISHED MATERIAL UNLESS OTHERWISE NOTED.
- SEE SPEC SECTION 01220 UNIT PRICES FOR LIST OF UNIT PRICES.

GENERAL INSTRUCTIONS TO BIDDERS:

MILLWORK:
 PKG 1 GC TO REMOVE BEAD BOARD (8'-4" PERPENDICULAR TO THE WALL / UNDER BUILT IN GUTTERS). DISCARD ANY BEAD BOARD THAT IS DAMAGED. ANY BEAD BOARDS THAT ARE IN 'GOOD' CONDITION NEED TO BE STOCKPILED IN THE GYMBOXING FOR THE PKG 2 CONTRACTOR.
 BEAD BOARD THAT IS REMOVED FOR BLOWN IN INSULATION @ GYMBOXING GABLE DORMERS NEEDS TO BE REPLACED BY PKG 1 GC. PKG 2 GC SHALL BE RESPONSIBLE FOR FINISHING/PAINTING OF THIS BEAD BOARD, SO IT BLENDS IN WITH THE REST OF THE BEAD BOARD CEILING.
 PKG 2 GC TO INSTALL NEW GYMBOXING DORMER LOUVERS WITH THE WOOD FRAMING AND INSULATION EXPOSED TO THE INTERIOR. NEW BEAD BOARD AND ASSOCIATED TRIM AS WELL AS FINISHING BY PKG 2 GC.

WINDOWS/DOORS:

PKG 1 GC TO INSTALL NEW WINDOWS / DOORS WITH SEALANT @ BOTH EXTERIOR AND INTERIOR LOCATIONS. ANY DAMAGE OF NEW WINDOWS/DOORS PRIOR TO PKG 2 GC WORK SHALL BE PHOTOGRAPHED AND BROUGHT TO THE ATTENTION OF THE ARCHITECT PRIOR TO THE COMMENCEMENT OF PKG 2 WORK. ANY DAMAGE (REPAIR/TOUCH UP WORK) AFTER THE COMMENCEMENT OF PKG 2 WORK IS THE RESPONSIBILITY OF PKG 2 GC. AREA ADJACENT TO WINDOW INSTALLATION MUST BE CLEAN OF DEBRIS READY FOR MILLWORK INSTALLATION BY PKG 2 GC. PKG 1 GC TO INSTALL NEW EXTERIOR DOORS AND FRAMES AT WEST WALLS (AT FUTURE PKG 2 EGRESS STAIRS). PKG 1 GC TO FOLLOW INSTRUCTIONS ON DOOR SCHEDULE. PKG 2 GC TO REINSTALL THESE DOORS. PKG 1 GC TO INSTALL INSULATED ATTIC HINGED HATCH AT EXISTING SHAFT LADDER.

INSULATION / OPENINGS:

THERE IS EXISTING BATT INSULATION AT THE ATTIC FLOOR. PKG 1 GC TO KEEP EXISTING AND ADD R-21 (5.5 IN) TO EXISTING ACCESS TO UNDERSIDE OF ROOF RAFTERS FOR NEW BATT INSTALLATION - PKG 1 GC TO PROVIDE SCAFFOLDING FOR ABOVE AUDITORIUM, MASONRY OPENING EACH SIDE OF THE AUDITORIUM (SEE STRUCTURAL), AND NEW OPENING AT NORTH SIDE AT STAIRKITCHEN VESTIBULE - USE PREVIOUS OPENING THAT WAS BOARDED UP. PKG 1 GC TO LEAVE OPEN. PKG 2 GC TO PATCH AND REPAIR CELING.

GENERAL HISTORIC NOTES

- THE RECREATION CENTER IS LISTED ON THE PHILADELPHIA REGISTER OF HISTORIC PLACES. THE INTENT IS TO PROVIDE 100 YEAR REPAIRS TO THESE STRUCTURES. ALL WORK MUST CONFORM TO THE NATIONAL PARK SERVICE STANDARDS FOR REHABILITATION AND RESTORATION. ALL EXISTING HISTORIC BUILDING COMPONENTS ARE TO REMAIN IN PLACE TO THE GREATEST EXTENT POSSIBLE. HISTORIC BUILDING ELEMENTS ARE TO BE RESTORED WHENEVER POSSIBLE. IF REPLACEMENT IS NECESSARY, REPLACE WITH APPROVED MATERIALS, HAVING EXACT DIMENSIONS AND MATCHING HISTORIC MATERIALS, U.N.O. PROCEED WITH REPLACEMENT AFTER DIRECTION FROM ARCHITECT. DO NOT USE METHODS WHICH WILL RESULT IN UNNECESSARY LOSS OF DETAIL OR MATERIAL IN EXISTING SURFACES. WHEN IN QUESTION, REFER TO THE US DEPARTMENT OF THE INTERIOR GUIDELINES FOR THE RESTORATION OF HISTORIC STRUCTURES.
- PROVIDE MOCK-UPS AND TEST PANELS AS INDICATED ON THE DRAWINGS AND SPECIFICATIONS. LOCATIONS AS SPECIFIED BY ARCHITECT. WORK SHALL NOT PROCEED WITHOUT APPROVAL OF THE MOCKUPS.
 A. TEST PANELS AND MOCKUPS TO INCLUDE, BUT ARE NOT LIMITED TO:
 a. CLEANING PANELS AT ALL MASONRY TYPES AND STAINS AS SPECIFIED
 b. REPAIR AND REPLACEMENT AT GRANITE, LIMESTONE, AND BRICK
 c. MORTAR TIE AND COLOR
- ALL DIMENSIONS AND EXISTING CONDITIONS SHALL BE CHECKED AND VERIFIED BY THE CONTRACTOR PRIOR TO PROCEEDING WITH THE WORK.
- A BINOCULAR SURVEY WAS CONDUCTED TO DETERMINE THE FAÇADE REPAIR AND CLEANING SCOPE. SELECT AREAS WERE SURVEYED VIA PROBE AND HIGH-REACH VISUAL INSPECTION. THE CONTRACTOR SHALL INFORM DESIGN PROFESSIONAL IN WRITING OF ANY DISCREPANCIES ON DRAWINGS PRIOR TO PROCEEDING WITH THE WORK.
- CONTRACTOR SHALL NOTIFY DESIGN PROFESSIONAL AT ONCE OF UNSEEN EXISTING CONDITIONS ENCOUNTERED DURING THE COURSE OF THE WORK, WHICH MAY AFFECT THE DESIGN MODIFICATIONS.
- THE CONTRACTOR SHALL PROVIDE REQUEST FOR CHANGE, JUSTIFICATION, SHOP DRAWINGS, PROJECT COST AND SCHEDULE IMPACT FOR PROPOSED MODIFICATIONS TO THE CONTRACT DRAWINGS. CONTRACTOR SHALL PROVIDE REPLACEMENT QUANTITIES, PREPARED WITH REPLACEMENT AFTER DIRECTION FROM ARCHITECT. PROVIDE TEMPORARY PROTECTION.
- ALL NEW ELEMENTS (WOOD, STONE, BRICK, TERRA COTTA REPLACEMENT, AND GFRC) TO MATCH EXISTING PROFILES, COLOR (AFTER CLEANING), AND DIMENSIONS EXACTLY.
- RAKE OUT ALL EXISTING SEALANTS, BOND BREAKERS AND RELATED ITEMS FROM ALL CONTROL JOINTS, EXPANSION JOINTS AND FLASHING LOCATIONS WHERE INDICATED. PROVIDE PRIMERS, BOND BREAKERS, COMPRESSIBLE FOAM ROOF WHERE REQUIRED BY MANUFACTURER. APPLY SEALANT AT CONTROL JOINTS AND OTHER LOCATIONS, ALLOWING FOR PROPER SEALANT MOVEMENT. SEALANT COLORS TO BE SELECTED BY ARCHITECT.
- SEE ELEVATIONS AND WINDOW SCHEDULE SHEETS FOR WINDOW REPLACEMENT SCOPE.
- SEE DWGS A201-R.1 THROUGH A204-R.1 FOR EXTERIOR MASONRY SCOPE OF WORK.
- SEE DWGS A104-R.1, A610-R.1, A611-R.1, A631-R.1, A632-R.1 FOR ROOFING SCOPE.
- SEE DWG A612-R.1 FOR MASONRY REPAIR DETAILS. SEE ELEVATIONS NEW WORK DWGS A201-R.1 THROUGH A204-R.1 FOR TYPES AND LOCATIONS OF REPAIRS.
- ALL SURFACE PREPARATION FOR PAINT AND SEALANT WORK SHALL MEET SSP-22 HAND TOOL CLEANING.

DEMOLITION GENERAL NOTES:

- HAZARDOUS MATERIAL ABATEMENT IS NOT IN CONTRACT. IT WILL BE CONDUCTED AFTER THIS PHASE, BUT BEFORE THE SECOND PHASE OF THE PROJECT. SEE ABATEMENT WORK PLAN & SPECIFICATIONS. PER REPORT, LEAD PAINT IS ALSO PRESENT AT WORK AREAS. ALL DISTURBANCE ACTIVITIES SHALL COMPLY WITH ALL APPLICABLE FEDERAL, STATE, AND LOCAL REGULATIONS INCLUDING OSHA 29 CFR 1926.62.
- WORK SHALL BE CONDUCTED UNDER THE ASSUMPTION THAT ALL SURFACE COATINGS CONTAIN LEAD. ALL DISTURBANCE ACTIVITIES SHALL COMPLY WITH ALL APPLICABLE FEDERAL, STATE, AND LOCAL REGULATIONS INCLUDING OSHA 29 CFR 1926.62. WORK ACTIVITIES SHALL ENSURE AREAS BEYOND WORK AREA ARE NOT CONTAMINATED. REFER TO SECTION 01040 FOR ANY ADDITIONAL REQUIREMENTS.
- REFERENCE DEMOLITION ELEVATIONS FOR EXTENT OF WINDOW AND FACADE DEMOLITION SCOPE.
- SEE MEPFP DRAWING FOR REMOVAL OF MEPFP SYSTEMS.
- CONTRACTOR TO VERIFY ALL EXISTING CONDITIONS PRIOR TO CONSTRUCTION.
- BEFORE STARTING WORK, MAKE A THOROUGH EXAMINATION OF THOSE PORTIONS OF THE STRUCTURE IN WHICH THE WORK IS TO BE PERFORMED. CHECK ALL THE WORK ADJOINING OR AT UNDERLYING LOCATIONS. REPORT TO THE ARCHITECT ANY AND ALL CONDITIONS WHICH MAY INTERFERE WITH OR OTHERWISE AFFECT OR PREVENT THE PROPER EXECUTION AND COMPLETION OF THE WORK. DO NOT START THE WORK UNTIL SUCH CONDITIONS HAVE BEEN EXAMINED AND A COURSE OF ACTION MUTUALLY AGREED UPON.
- CONTRACTOR SHALL PERFORM ALL NECESSARY DEMOLITION AS REQUIRED FOR INSTALLATION OF NEW WORK AS SHOWN ON THE DRAWINGS. ALL DEMOLITION NOT SPECIFICALLY SHOWN BUT NECESSARY TO COMPLETE THE PROJECT AS SHOWN SHALL BE THE RESPONSIBILITY OF THE CONTRACTOR.
- PRIOR TO THE START OF DEMOLITION, THE CONTRACTOR SHALL CALL TO THE ATTENTION OF THE OWNER: ANY DAMAGE, CRACKS OR OTHER IMPERFECTIONS IN THE WORK ADJACENT TO DEMOLITION AREAS.
- CONTRACTORS SHALL INSPECT AND ASSESS EACH SPACE, AREA, OR SURFACE, AND FULFILL THE INTENT OF THE WORK REQUIRED BY THE CONTRACT DOCUMENTS. DEVIATIONS REQUIRED BY FIELD CONDITIONS SHALL BE BROUGHT TO THE ATTENTION OF THE ARCHITECT BEFORE PROCEEDING.
- ANY CUTTING AND REMOVAL INDICATED ON THE DRAWINGS ARE GENERAL INDICATIONS ONLY AND DO NOT NECESSARILY SHOW THE FULL EXTENT OF CUTTING AND REMOVAL WHICH MAY BE REQUIRED BY JOB CONDITIONS.
- CONSTRUCTION AND EXISTING FINISHES SHALL REMAIN UNLESS NOTED OTHERWISE. DURING DEMOLITION WORK, PROPERLY PROTECT ALL EXISTING WORK SHOWN TO REMAIN. EXERCISE CARE WHEN REMOVING ADJACENT WORK. PROPERLY REPAIR TO THE ORIGINAL CONDITIONS. FILL DAMAGE TO ITEMS SHOWN TO REMAIN, CAUSED BY DEMOLITION PROCEDURES, TO THE SATISFACTION OF, AND AT NO ADDITIONAL COST, TO THE OWNER. PATCH SURFACE FINISHES BEHIND DEMOLITION WORK (I.E. FLOORS, WALLS, CEILINGS, ETC.) TO MATCH SURROUNDING CONDITIONS.
- BEFORE STARTING DEMOLITION OPERATIONS, PROVIDE THE NECESSARY PROTECTIVE BARRIERS AROUND TRAFFIC AREAS NEAR INTERIOR WORK AS REQUIRED AND IN STRICT ACCORDANCE WITH OSHA RULES AND REGULATIONS. PROTECT ALL EXISTING EQUIPMENT NOT DESIGNATED TO BE REMOVED. PERFORM ALL WORK REQUIRED TO PROTECT THE PUBLIC AND UTILITIES.
- TAKE NECESSARY PRECAUTIONS TO PREVENT DUST AND DIRT FROM RISING BY WETTING DEMOLISHED DEBRIS. EXCESSIVE USE OF WATER WILL NOT BE PERMITTED.
- CONTRACTOR SHALL BE RESPONSIBLE FOR PROVIDING ALL NECESSARY TEMPORARY BRACING AND / OR SHORING REQUIRED TO MAINTAIN THE INTEGRITY AND STRUCTURAL STABILITY OF THE BUILDING AND ITS INDIVIDUAL ELEMENTS.
- EXCEPT WHERE NOTED OTHERWISE, REMOVE ALL DEMOLISHED MATERIALS FROM THE SITE. DO NOT BURN OR BURY MATERIALS ON THE SITE. AT THE COMPLETION OF WORK FOR EACH DAY, CLEAN THE ENTIRE AREA INVOLVED AND LEAVE IT IN A NEAT CONDITION, FREE OF DEBRIS AND RUBBISH. KEEP ALL ADJOINING PUBLIC AREAS CLEAN AND FREE OF DEBRIS OR CONSTRUCTION MATERIALS DURING WORKING HOURS, AND MAKE AN EFFORT TO PROVIDE SAFE CONDITIONS FOR THE GENERAL PUBLIC AND WORKMEN. REFERENCE DIVISION 5 SPECIFICATION SECTION "CONSTRUCTION WASTE MANAGEMENT" FOR CONTRACTORS RESPONSIBILITY FOR WASTE REMOVAL / DISPOSAL.
- THE OWNER WILL REMOVE ALL EXISTING ITEMS THAT THE OWNER WISHES TO SALVAGE PRIOR TO START OF DEMOLITION. CONTRACTOR IS RESPONSIBLE FOR REMOVAL OF ALL REMAINING ITEMS.
- ARCHITECTURAL, STRUCTURAL, MECHANICAL, ELECTRICAL, PLUMBING, SITE, AND LANDSCAPE DRAWINGS, AND PROJECT SPECIFICATIONS MAY PROVIDE ADDITIONAL DEMOLITION REQUIREMENTS. THE CONTRACTOR SHALL BE RESPONSIBLE FOR BEING FAMILIAR WITH THESE DRAWINGS AND PROJECT SPECIFICATIONS AND ANY REQUIREMENTS PROVIDED BY THEM.
- PRIOR TO THE DEMOLITION OF THOSE ITEMS WHICH HAVE UTILITY CONNECTIONS (WATER, GAS, ELECTRICITY, STEAM, ETC.) THE CONTRACTOR SHALL ARRANGE WITH THE OWNER TO LOCATE SHUTOFF VALVES, PANEL BOXES AND OTHER CONTROL ELEMENTS, SO THAT WATER DAMAGE AND OTHER POTENTIALLY UNCONVENIENT OR DANGEROUS SITUATIONS ARE AVOIDED.
- REFERENCE PARTIAL DEMOLITION PLANS FOR SPECIFIC DEMOLITION REQUIREMENTS.
- REFERENCE DIVISION 01 SPECIFICATION SECTIONS FOR SELECTIVE DEMOLITION, CUTTING, AND PATCHING. TEMPORARY FACILITIES AND CONTROLS, SITE AND BUILDING DEMOLITION, CONSTRUCTION WASTE MANAGEMENT, AND RELATED SECTIONS FOR ADDITIONAL DEMOLITION REQUIREMENTS.
- CONTRACTOR SHALL BE RESPONSIBLE FOR COORDINATING DEMOLITION REQUIREMENTS WITH PROJECT PHASING. NOTIFY ARCHITECT PRIOR TO START OF WORK WITH ANY CONDITIONS WHICH MAY INTERFERE WITH OR OTHERWISE AFFECT OR PREVENT PROPER EXECUTION OF THE WORK.

PROJECT SUMMARY: EXTERIOR ENVELOPE PACKAGE

- REMOVAL OF ALL EXTERIOR DOORS AND FRAMES, EXCEPT MAIN ENTRY
- REMOVAL OF ALL WINDOW SASHES AND FRAMES EXCEPT AT THREE WINDOWS AT WEST ELEVATION AS SHOWN ON ELEVATIONS AND SCHEDULE. ONLY SASHES TO BE REMOVED.
- REMOVAL OF WINDOW INFFILL, MISC. LOUVERS, ETC. AS SHOWN
- REMOVAL OF ALL BUILDING MOUNTED UTILITIES, SIGNAGE, LIGHTING, CAMERAS, AND OTHER EQUIPMENT IN PREPARATION FOR THE NEW WORK
- REMOVAL OF ROOFING DOWN TO DECK AND AS OTHERWISE SHOWN.
- REMOVAL OF MASONRY AS REQUIRED FOR NEW DOOR OPENINGS.
- REMOVAL OF TERRACOTTA CORNICE, LINTELS, BALCONY AND RAILING, AND COPING AS SHOWN.
- NEW PAINTED STAINLESS STEEL DOORS.
- NEW METAL INSULATED WINDOWS.
- NEW ROOF, INCLUDING SHEATHING OR DECKING REPAIR AND INSULATION.
- NEW GFRC CORNICE, BALCONY, AND METAL RAILING.
- NEW LINTELS AND COPING AS SHOWN.
- MASONRY CLEANING, SOIL AND COATING AND PAINT REMOVAL, REPAIR/ REPLACEMENT OF SELECT ELEMENTS OR AREAS AS NOTED AND REPORTING.
- ABATEMENT OF HAZARDOUS MATERIALS IN SELECT AREAS REQUIRED FOR THE WINDOW INSTALLATION WILL BE PERFORMED BY OTHERS PRIOR TO GC WORK.

CODE DATA

- Applicable Codes**
 The following primary codes are applicable to this project:
- Building - 2018 Philadelphia Code, Incorporating the 2018 International Building Code (IBC) with local modifications.
 - Accessibility - Chapter 11 of 2021 IBC and the 2017 ICC/ANSI A117.1 Standards and the Americans with Disabilities Act Guidelines (ADAG).
 - Existing Building - 2018 International Existing Building Code (IEBC) as amended by the city of Philadelphia.
 - Fire Protection - 2018 Philadelphia Fire Code (PFC). The PFC is an amended version of the 2009 International Fire Code (IFC).
 - Plumbing - 2018 City of Philadelphia Plumbing Code (PPC).

PHILADELPHIA IEBC:

CHAPTER 3
 THE WORK AREA COMPLIANCE METHOD WILL BE USED.

CHAPTER 6
 LEVEL 3 ALTERATIONS APPLY AS THE WORK AREA DOES NOT EXCEED 50% OF THE BUILDING AREA. ALTERATIONS SHALL COMPLY WITH CHAPTERS 8 & 9 AND AS MODIFIED BY CHAPTER 12 HISTORIC BUILDINGS. HISTORIC BUILDING PROVISIONS SHALL APPLY TO BUILDINGS CLASSIFIED AS HISTORIC. THE STRUCTURE IS LISTED ON PHILADELPHIA REGISTER OF HISTORIC PLACES.

SECTION 705

ROOF REPLACEMENT SHALL COMPLY WITH REQUIREMENTS OF IBC CHAPTER 15 (ROOF ASSEMBLIES AND ROOFTOP STRUCTURES). THERE IS NO MINIMUM ROOF SLOPE REQUIREMENT PER 705.1 EXCEPTION 1.

PHILADELPHIA BC:
USE GROUP (CHAPTER 3):
 - ASSEMBLY (A5), ACCESSORY USES, BUSINESS (B), EDUCATIONAL, (E), STORAGE (S-1) NO CHANGE IN OCCUPANCY

CONSTRUCTION TYPE (CHAPTER 6):
 - IIB - EXTERIOR WALLS OF NONCOMBUSTIBLE MATERIALS. INTERIOR WALLS OF ANY MATERIAL PERMITTED BY THIS CODE.

FIRE RESISTIVE CONSTRUCTION FOR BUILDING TYPE IIB (TABLE 601):

Construction Type
 Section 602 Construction Type Classification IIB

BUILDING ELEMENT	TABLE 601: FIRE RESISTIVE REQUIREMENTS FOR BUILDING ELEMENTS (TYPE IIB CONSTRUCTION)	
	HEIGHT (STORIES)	RATING (HOURS)
BEARING WALLS:	EXTERIOR	2
	INTERIOR	0
INTERIOR NON-BEARING WALLS & PARTITIONS:	EXTERIOR	0
	ROOF CONSTRUCTION	0
FLOOR CONSTRUCTION		0

IIB, A-3, FULLY SPRINKLERED

TABLE 604.4	HEIGHT	ALLOWABLE	PROPOSED
TABLE 604.4	75 FT	75 FT	55 FT
TABLE 604.4	STORIES	3	3
TABLE 606.2	AREA	28,500 SF	
SECTION 506.3	FRONTAGE INCREASE	1,700	
	TOTAL AREA	30,200 SF	32,000 SF

NOTE: BUILDING IS NOT SPRINKLERED; SPRINKLERS WILL BE INSTALLED WITH PACKAGE 2 INTERIOR RENOVATION WORK.

This project meets the 2018 International Energy Code (per Chapter 5 Prescriptive Approach Compliance: Table C402.2: Opaque Thermal Envelope Requirements) by addressing the following items:

- This project complies with **Roofs: "Attic and other"**, which requires R-38 in the zone 4A Commercial (All Other):
 - High Roofs:
 - Existing Attic Floor Batt Insulation = R-30. This project includes adding 5.5" Mineral Wool Batt R-17.1 over the Attic Floor. This produces a total of R-47.1 which exceeds the Energy Code.
 - Low Roofs:
 - Existing Gym and Boxing Roofs:
 - At majority of roof: New 1.5" Polyiso R-9.7 and 10" Mineral Batt Insulation R-31.5 = R-41.2 which exceeds the Energy Code.
 - At existing gable dormers: New 1" Polyiso R-6.5 and 10" Mineral Batt Insulation R-31.5 = R-38 which meets the Energy Code.
 - At new hip roofed dormers: New 1.5" Polyiso R-9.7 and 9.25" Mineral Batt Insulation R-39 = R-38.7 which exceeds the Energy Code.
 - This project complies with **Walls, Above Grade: "Wood framed and other"**, which requires R-20 in the zone 4A Commercial (All Other):
 - New Walls, Dormer and Window Infills will comply with R-21 Mineral Batt insulation 5.5" which exceeds the Energy Code.

REVISIONS

ISSUE	DATE	DESCRIPTION
1	5/15/23	ISSUE FOR PERMIT
2	5/19/23	ADDENDUM 1



REVIEWED BY:

PROJECT COORDINATOR

SEALS




KELLY MAIELLO ARCHITECTS
 1420 Walnut Street, 15th Floor
 Philadelphia, PA 19102
 www.kmarchitects.com

LANDSCAPE ARCHITECT:
 Salt Design Studio
 161 Leverington Ave, Suite 1005
 Philadelphia PA 19127
 www.saltdesignstudio.com

STRUCTURAL / M.E.P. / F.P. / SITE CIVIL ENGINEERS:
Pennoni Associates
 1900 Market Street Suite 300
 Philadelphia PA 19103
 www.pennoni.com

LEED CONSULTANT:
Verde Architecture Consulting
 1635 Market Street Suite 1600
 Philadelphia PA 19103

CITY OF PH

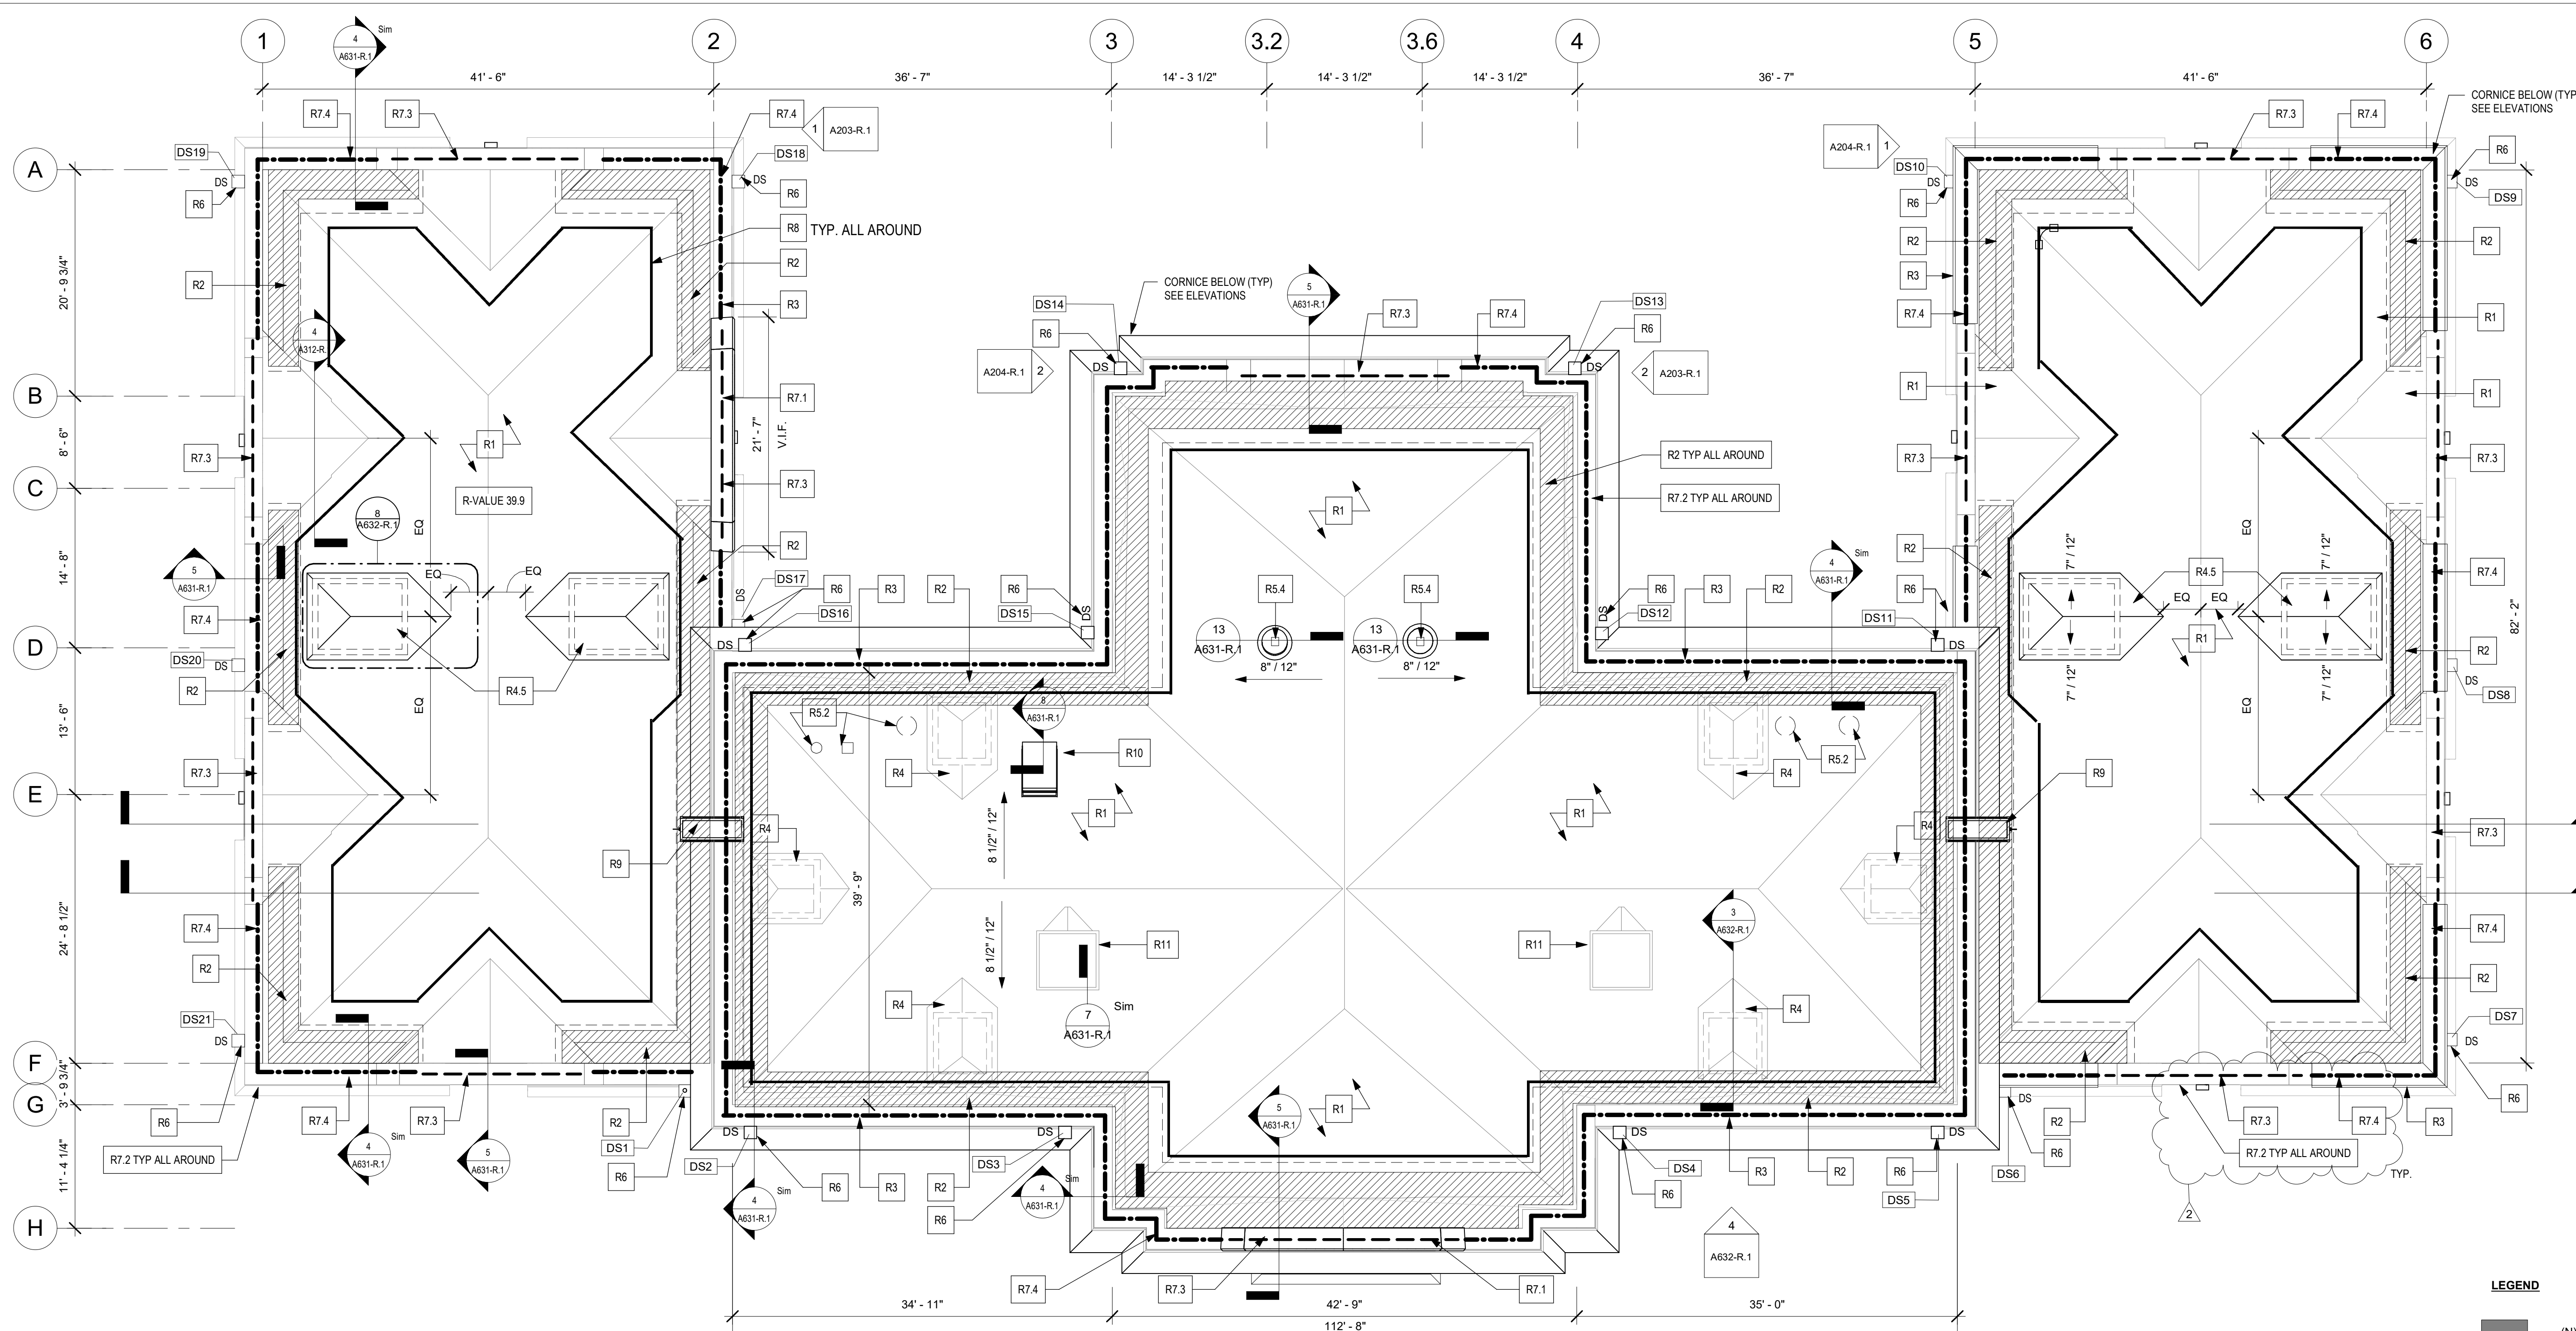


- GENERAL NOTES:**
- SEE ELEVATIONS FOR NEW MASONRY WORK AT FRONT SIDE OF PARAPET AND AT CHIMNEYS.
- KEYNOTES - ROOF**
- R1: PITCHED SHINGLE ROOF**
- PREPARE FOR INSTALLATION OF NEW FINISH ROOF.
 - INSTALL NEW INSULATION
 - INSTALL NEW SHEATHING
 - INSTALL NEW UNDERLAYMENT
 - INSTALL NEW ASPHALT SHINGLE AT ALL PITCHED ROOFS AS SHOWN.
 - SEE ROOF DETAILS 6A631-R.1 FOR LOW ROOF AND 6A631-R.1 FOR HIGH ROOF.
- R2: BUILT-UP GUTTER**
- INSPECT ROOF DECK AND MAKE NECESSARY REPAIRS. REPLACEMENT B.O.D. 1"X6" T&G BOARD. ASSUME 30" OF LOWER PORTION AT FULL PERIMETER.
 - PREPARE ROOF DECK FOR INSTALLATION OF NEW GUTTER LINER. INSTALL 1/2" CDX UNDERLAYMENT. SEE ROOF DETAILS.
 - INSTALL NEW GALVANIZED GUTTER LINER AT BUILT-IN GUTTER. SEE ROOF DETAILS 6A631-R.1 FOR LOW ROOF AND 6A631-R.1 FOR HIGH ROOF.
- R3: PARAPET**
- REPORTING. 100% REPOINTING AT ROOF FACING SIDE
 - EXTERIOR SIDE - SEE ELEVATIONS
 - ALLOW FOR +/- 100 BRICK UNITS. REPLACEMENT AT ROOF-FACING SIDE.
 - SAW-CUT REGLETS AT RISING WALLS.
- R4: DORMERS**
- REPAIR/REPLACE EXISTING WOOD SHEATHING. PREP EXISTING DORMERS FOR NEW METAL CLADDING.
 - INSTALL NEW ASPHALT SHINGLE ROOF. FLAT SEAM METAL CLADDING, EAVE TRIM, AND METAL FLASHING.
 - INSTALL NEW WINDOWS/LOUVERS - SEE WINDOW SCHEDULE
 - REPLACE STEP FLASHING AT DORMER CHIEK WALLS
 - NEW HIPPED ROOF DORMER. LOUVER, & CHEEK WALLS TO MATCH (E) DORMERS IN MATERIAL AND STYLE
- R5: PENETRATIONS**
- VENT PIPE, EXHAUST FANS, OR AIR INTAKE: COORD W/ MEP FOR LOCATIONS
 - (N) OPENINGS IN ROOF FOR MECHANICAL - FINAL SIZE AND LOCATION TO BE DETERMINED UPON FINAL DESIGN OF MECHANICAL SYSTEM IN PACKAGE 2. (SEE MECH DWGS.)
 - CONTRACTOR TO PROVIDE FRAMED OPENING, NEW CURB OR SLEEVE AND FLASHING FOR EACH ROOF PENETRATION.
 - PROVIDE TEMPORARY PLYWOOD CAP WITH MEMBRANE ROOFING.
 - MODIFY EXISTING OPENINGS FOR NEW PENETRATIONS
 - SEE ROOF DETAILS 6A31-R.1 AND MEP DWGS FOR SCOPE
- R6: SCUPPER & LEADER**
- INSTALL INTEGRAL SCUPPER AND CONDUCTOR HEAD. CONNECT TO DOWNSPOUTS. SEE SHEET A631-R.1
 - PROVIDE VIDEO SCOPE AT DOWNSPOUT LOCATIONS FROM GROUND OUT TO 15'
- R7: COPING (LIMESTONE)**
- REPLACE COPING W/ NEW TO MATCH AS NOTED.
 - REPORTING. 100% REPOINTING
 - FURNISH AND INSTALL TEE CAPS AT EXIST LIMESTONE PARAPET WALLS - SEE LEGEND
 - FURNISH AND INSTALL METAL COPINGS OVER LIMESTONE PARAPET WALLS - SEE LEGEND
- R8: FALL ARREST SYSTEM**
- INSTALL PERSONAL FALL ARREST ANCHORAGE CONNECTOR DEVICES COMPLYING WITH ANSISASSE Z 398.1
 - ANCHORS PLACED PER CODE & MANUF. INSTALLATION RECOMMENDATIONS ALONG HIP AND RIDGE LINES. MAX. 10 FT FROM ROOF EDGE AND AT ROOF ACCESS HATCH OPENING
 - MOUNT CABLE SYSTEM APPROX. 3'-4" IN FROM EDGE ON SLOPED ROOF
 - BASES OF DESIGN: 3M 8MM PERMANENT CABLE ANCHOR SYSTEM
- R9: ROOF LADDERS**
- INSTALL METAL ROOF LADDERS FROM HIGH ROOF TO LOW ROOFS WITH EXTENDED PLATFORM AS REQUIRED TO CLEAR CORNICES
- R10: ROOF ACCESS**
- INSTALL NEW ROOF HATCH (APPROX. 36" X 54") & INTERIOR HATCH ACCESS LADDER (APPROX. 5'-0" H) WITH EXTENSION POLE
 - AT EXISTING INTERIOR LADDER ROOF ACCESS CLOSET 204A, PROVIDE OSHA-COMPLIANT VERTICAL LIFELINE SYSTEM (HARNES BY OTHERS)
 - SEE STRUCTURAL DRAWINGS FOR MODIFICATIONS TO ROOF FRAMING.
- R11: CHIMNEY**
- REPAIR CRACKS IN CHIMNEY - SEE MASONRY REPAIR CHART AND ELEVATIONS
 - REPLACE STEP FLASHING @ MASONRY AND CRICKETS
 - RESET AND REPOINT LIMESTONE CAP - SEE MASONRY REPAIR CHART AND ELEVATION

LEGEND

	(N) WINDOW OR DOOR INFILL		FALL ARREST SYSTEM
	(E) WINDOW OR DOOR INFILL TO REMAIN - SEE ELEVATIONS		(N) COPING CAP OVER (E) LIMESTONE CAP
	DOOR TAG		(N) LEAD TEE CAP
	WINDOW TAG		EXTENT OF GUTTER MEMBRANE/LINER
	WALL TAG		(N) BATT INSULATION IN ATTIC - SEE GENERAL NOTES ON G101-R.1
	DOWNSPOUT TAG		AREA OF NEW GALVANIZED GUTTER LINER - SEE DLT 5A631-R.1 FOR HIGH ROOF AND 6A631-R.1 FOR LOW ROOF
	N.I.C.		

1 ROOF PLAN
1/8" = 1'-0"

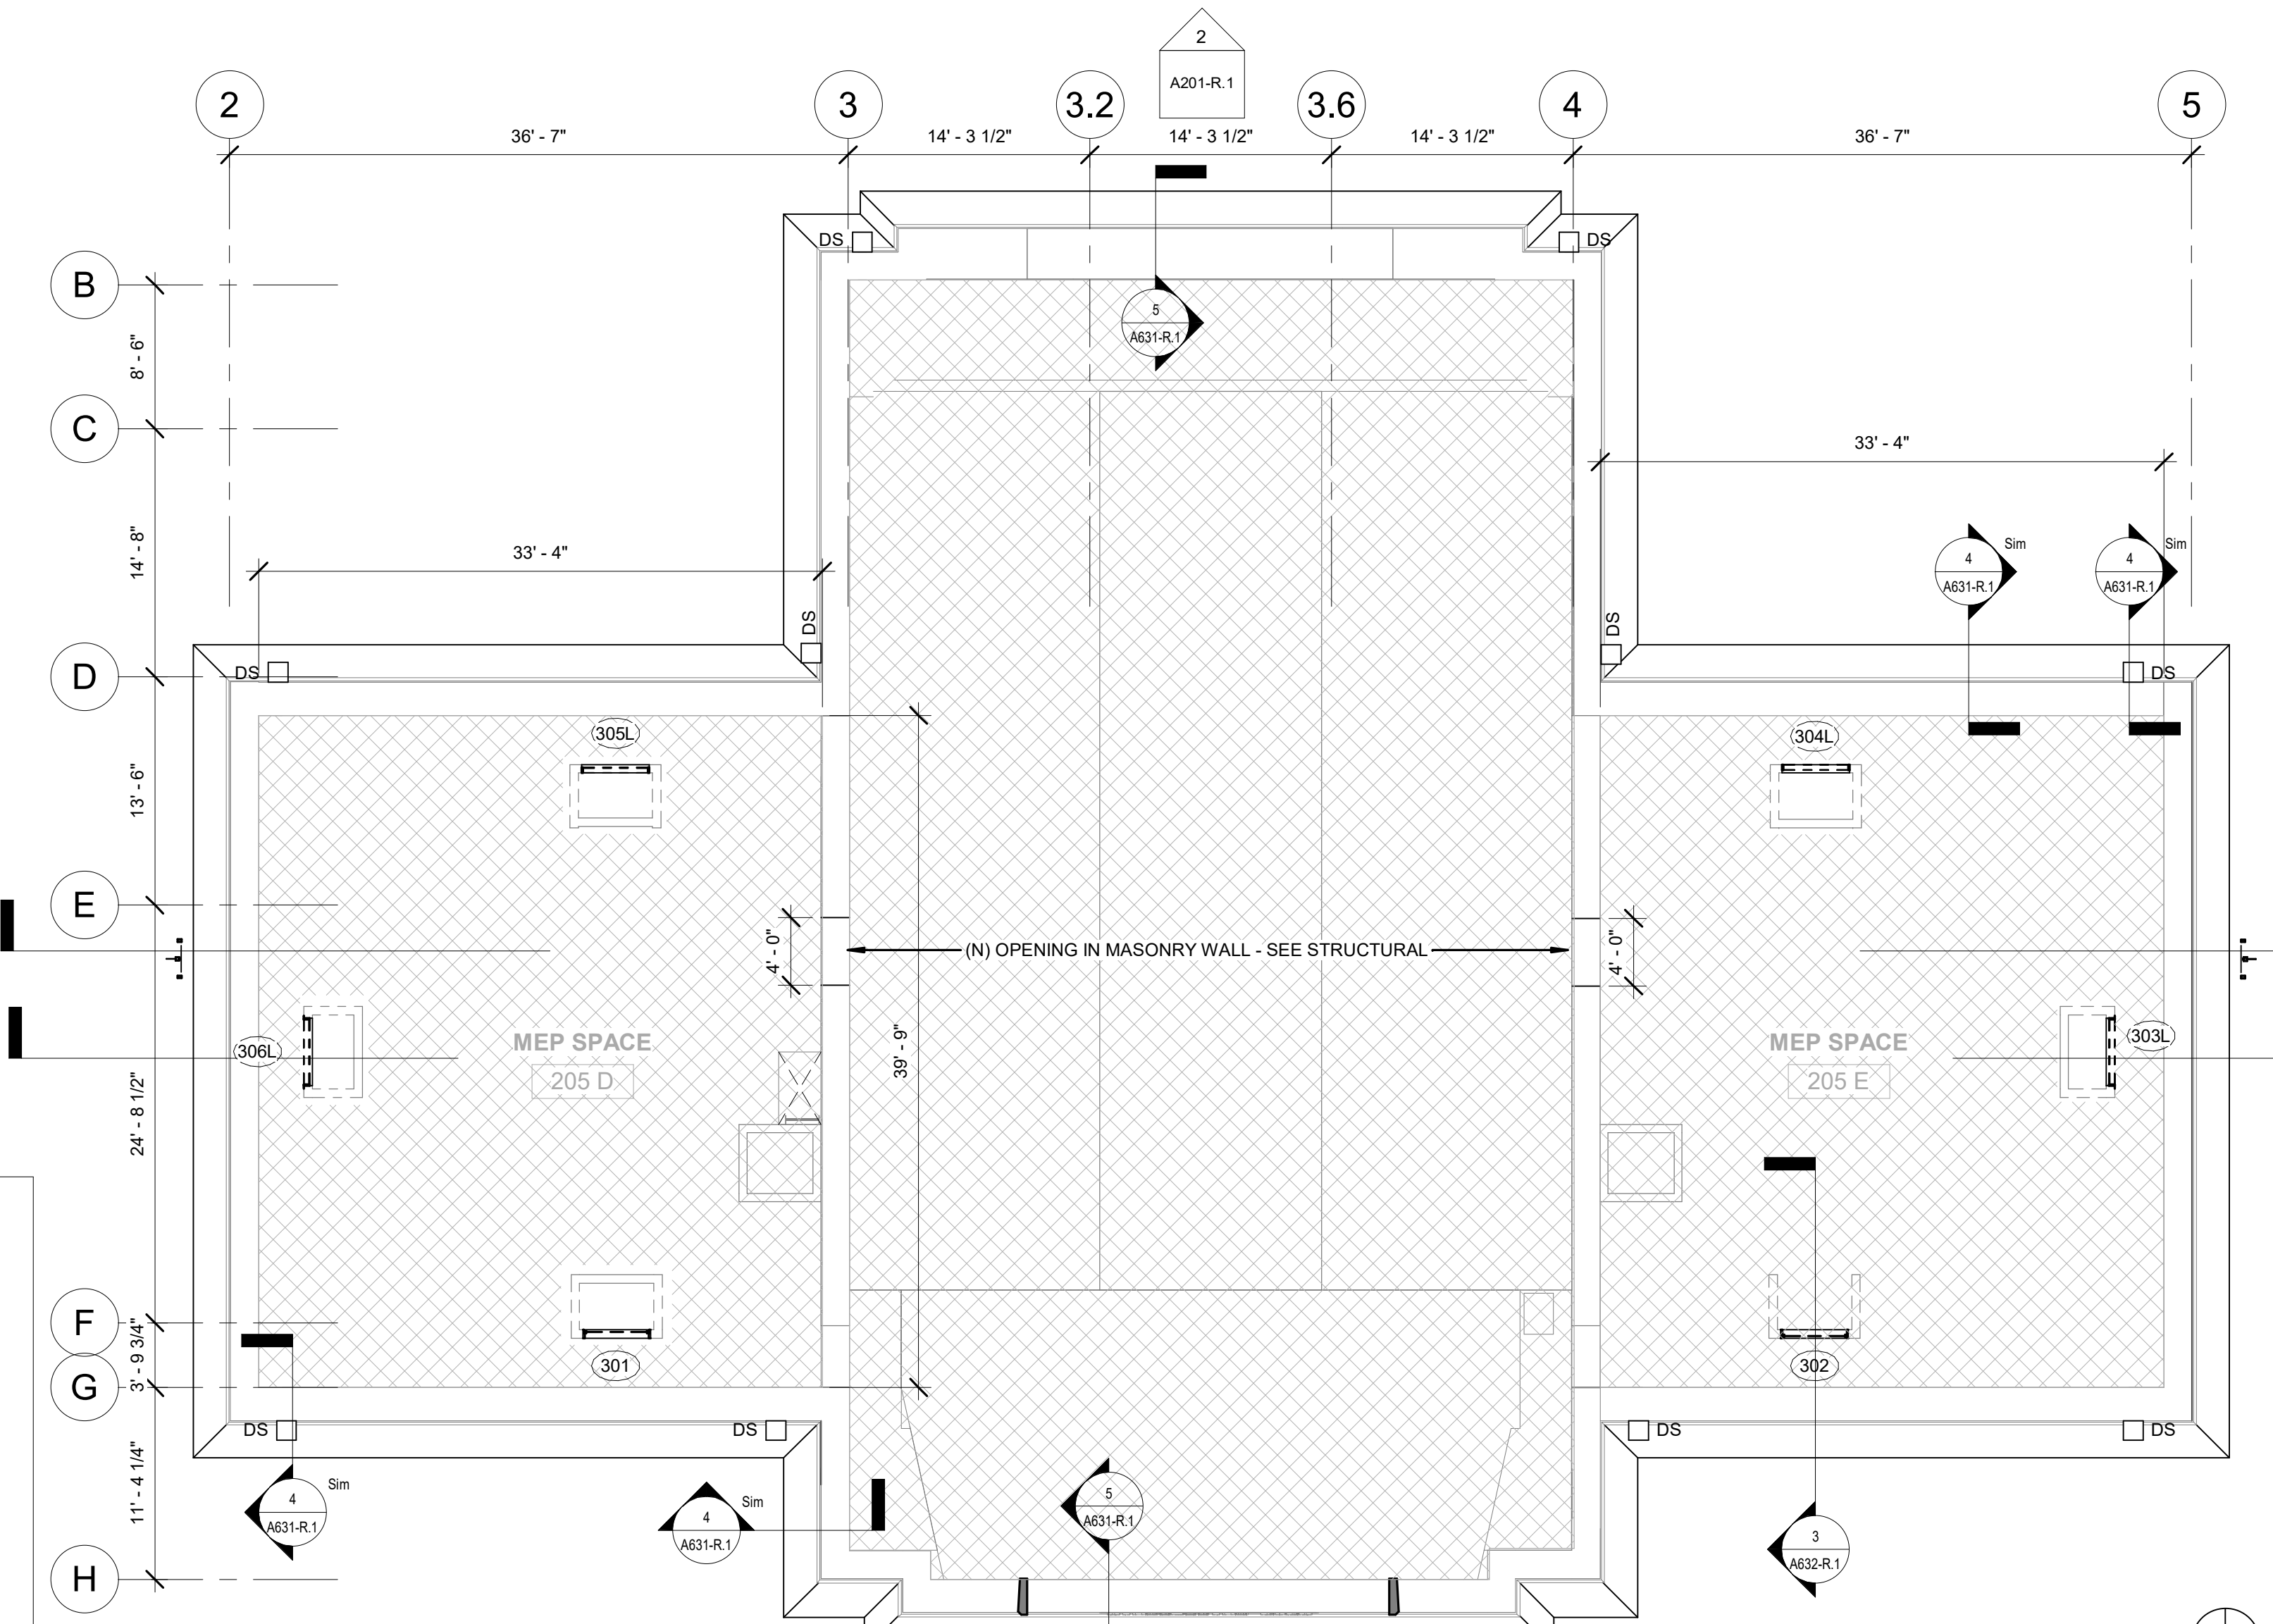

2 ATTIC PLAN
1/8" = 1'-0"



STAMP AREA

REVISIONS

ISSUE	DATE	DESCRIPTION
1	5/15/23	ISSUE FOR PERMIT
2	5/19/23	ADDENDUM 1



REVIEWED BY:

PROJECT COORDINATOR:

SEALS:



KELLY MAIELLO ARCHITECTS
1420 Walnut Street, 15th Floor
Philadelphia, PA 19102
www.kmarchitects.com

LANDSCAPE ARCHITECT:
Salt Design Studio
161 Leverington Ave, Suite 1005
Philadelphia PA 19127
www.saltdesignstudio.com


STRUCTURAL / M.E.P. / F.P. / SITE CIVIL ENGINEERS:
Pennoni Associates
1900 Market Street Suite 300
Philadelphia PA 19103
www.pennoni.com

LEED CONSULTANT:
Verde Architecture Consulting
1635 Market Street 1600
Philadelphia PA 19103

CITY OF PHILADELPHIA
REBUILD / PHILADELPHIA PARKS AND RECREATION
1515 ARCH STREET
5TH FLOOR, ONE PARKWAY BUILDING
PHILADELPHIA PENNSYLVANIA

PROJECT TITLE
KINGSSESSING RECREATION CENTER BUILDING AND SITE IMPROVEMENTS - PACKAGE 1

KEY PLAN

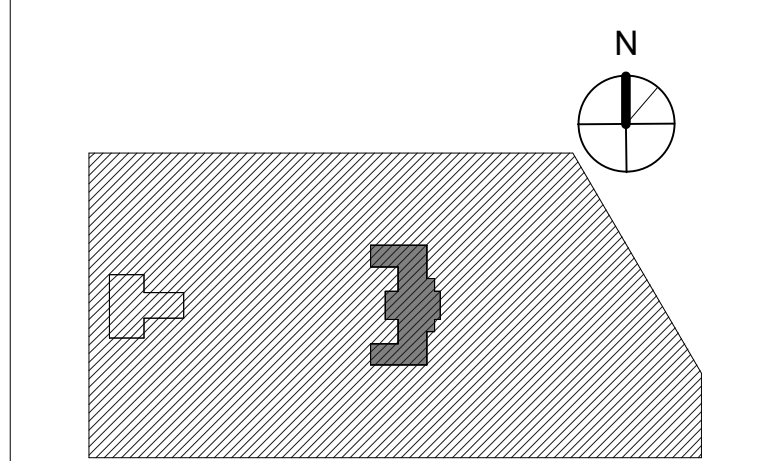

DRAWING TITLE
NEW WORK - ATTIC & ROOF

PROJECT NO. 21070	DRAWING NO.
DATE 05/15/23	A104-R.1
SCALE As Indicated	
DRAWN BY AF	
CHECKED BY DB	

NOTE: ALL DIMENSIONS AND CONDITIONS SHALL BE VERIFIED BY THE CONTRACTOR AT THE SITE BEFORE PROCEEDING WITH THE WORK.

REVISIONS

ISSUE	DATE	DESCRIPTION
1	5/15/23	ISSUE FOR PERMIT
2	5/19/23	ADDENDUM 1



REVIEWED BY:

PROJECT COORDINATOR

SEALS



KELLY MAIELLO ARCHITECTS
1420 Walnut Street, 15th Floor
Philadelphia, PA 19102
www.kmarchitects.com

LANDSCAPE ARCHITECT:
Salt Design Studio
161 Levering Ave, Suite 1005
Philadelphia PA 19127
www.saltdesignstudio.com


STRUCTURAL / M.E.P. / F.P. / SITE CIVIL ENGINEERS:
Pennoni Associates
1900 Market Street Suite 300
Philadelphia PA 19103
www.pennoni.com

LEED CONSULTANT:
Verde Architecture Consulting
1635 Market Street Suite 1600
Philadelphia PA 19103

CITY OF PHILADELPHIA
REBUILD / PHILADELPHIA PARKS AND RECREATION
1515 ARCH STREET
5TH FLOOR, ONE PARKWAY BUILDING
PHILADELPHIA PENNSYLVANIA

DRAWING TITLE
KINGSSESSING RECREATION CENTER BUILDING AND SITE IMPROVEMENTS - PACKAGE 1


KEY PLAN

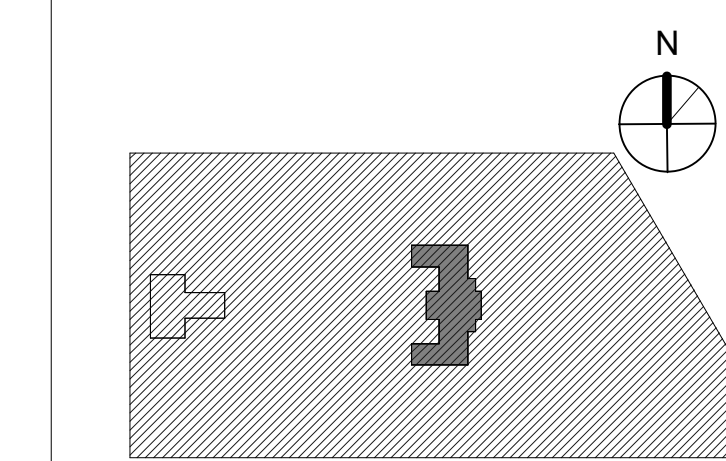


BUILDING ELEVATIONS - EAST

PROJECT NO.	DRAWING NO.
21070	
DATE	05/15/23
SCALE	As Indicated
DRAWN BY:	AF
CHECKED BY:	DB

NOTE: ALL DIMENSIONS AND CONDITIONS SHALL BE VERIFIED BY THE CONTRACTOR AT THE SITE BEFORE PROCEEDING WITH THE WORK.

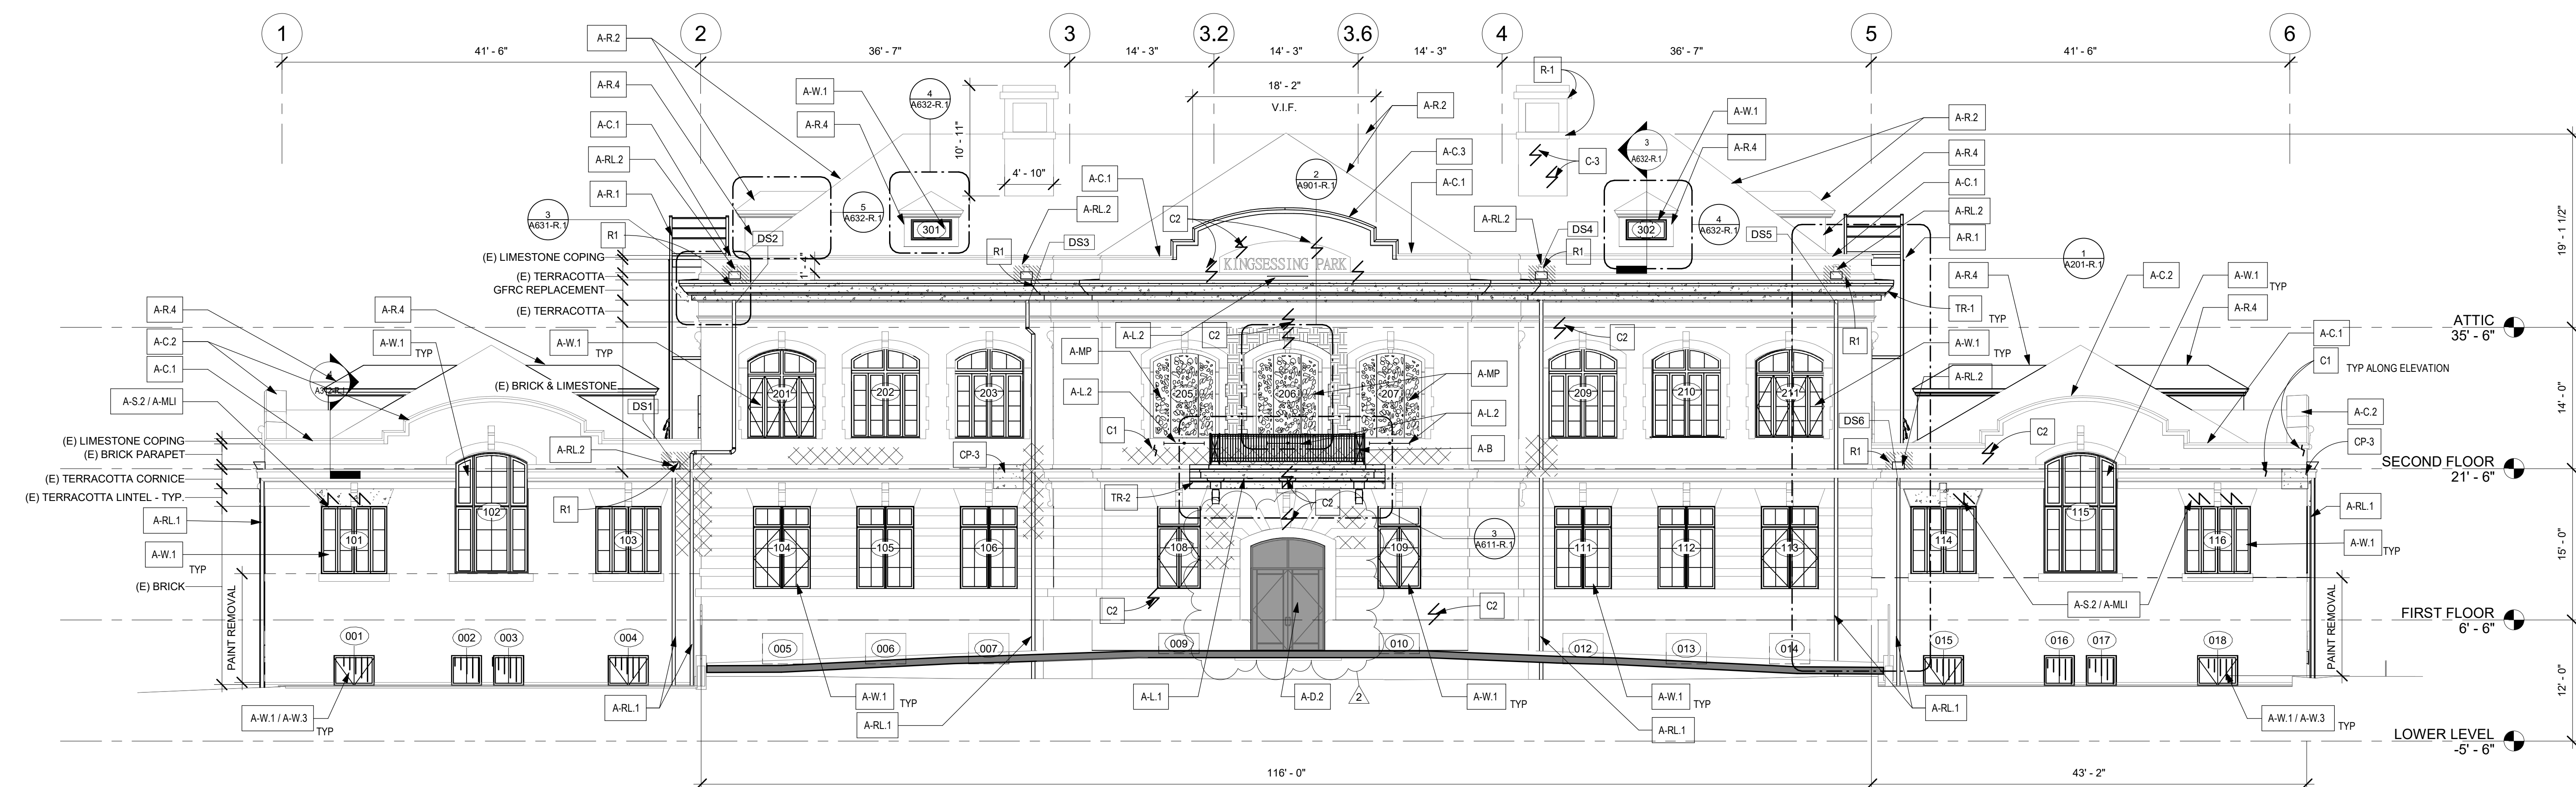

2 EAST ELEVATION - NEW WORK
1/8" = 1'-0" REFERENCE DETAIL: 1 / A101-R.1

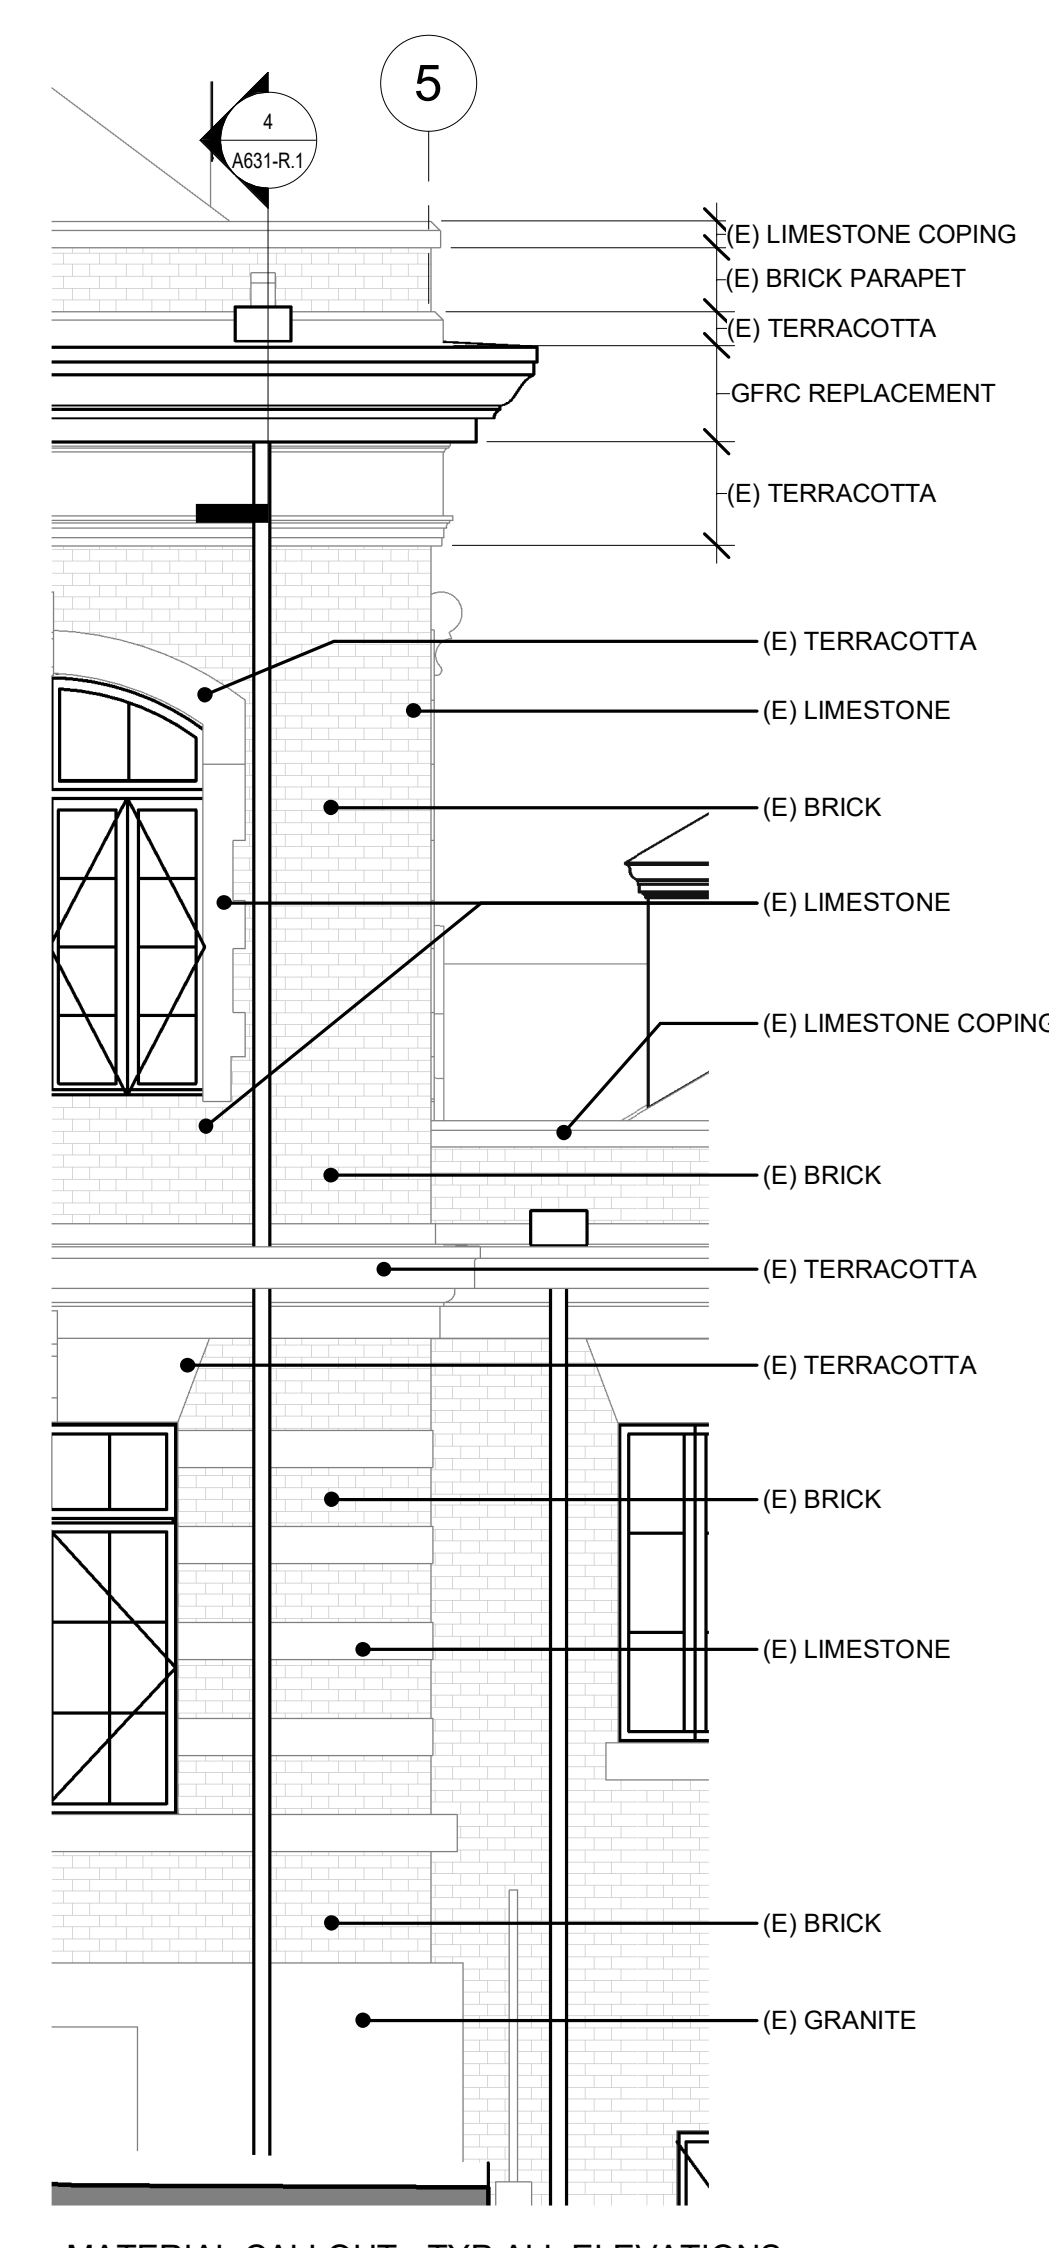

1 MATERIAL CALLOUT - TYP ALL ELEVATIONS
1/4" = 1'-0"

STAMP AREA

MASONRY REPAIR SCHEDULE

MARK	Condition	Substrate	Treatment	Basis of Design	Color	Comments	Quantities
Masonry Repair							
RP-1	Aged/ Deteriorated/Open / failed mortar joints	Brick	100% Repoint - mortar	Jahn 110 pointing mortar	Assume up to 5	See SHEET A611-R	4680 SF
RP-2	Aged/ Deteriorated/Open / failed mortar joints	Terracotta cornice, string band, sill band, and keystone	100% Repoint - mortar	Jahn 110 pointing mortar	Assume up to 5	See SHEET A611-R	900 SF
RP-3	Aged/ Deteriorated/Open / failed mortar joints	Limestone quoins, window surround, banding	100% Repoint - mortar	Jahn 110 pointing mortar	Assume up to 5	See SHEET A611-R	975 SF
RP-4	Aged/ Deteriorated/Open / failed mortar joints	Granite Base & water table course	100% Repoint - mortar	Jahn 110 pointing mortar	Assume up to 5	See SHEET A611-R	475 SF
RP-S	Joints at skyward coping stones	Terracotta, limestone	100% Repoint and Sealant - See roof plan	Silicone sealant, non-sag, single component	Match Stone	Remove existing joint material and clean prior to installing	150 SF
DM	Spalled Stone	Granite, Limestone	Stone Dutchman Repair	Natural stone - match	Match Stone	See SHEET A611-R	-
RT	Surface Deterioration	Granite	Retool surface to sound material	N/A	N/A	Notify design team if more than 1" of surface material is removed	Assume 40 SF
TR-1	Deteriorating / broken cornice	Terracotta	Replace upper cornice in full with GFRC units	See Spec Section 09xxxx GFRC	Match Existing terracotta color and texture	See SHEET A611-R	125 LF
TR-2	Deteriorating / broken balcony	Terracotta	Replace balcony with GFRC		Match Existing terracotta color and texture	See SHEET A611-R Coordinate with railing work - see details	20 LF
C-1	Masonry Crack	All masonry - Vertical cracks (typ at joints)	Saw out joint, install EJ C-2 Repair of units as needed / indicated	See Spec	Match Substrate	Assume avg 10 brick repair at each location	40 LF
C-2	Masonry Crack	All masonry, diagonal and/or thru unit		Brk or Soft Stone: Cathedral Stone M32 or M35 injection grout; Granite & Limestone: Cathedral Stone M31 injection grout	Match Substrate	M35 for voids larger than 3/8" Assume ave 5 brick repair at each location	40 LF
C-3	Masonry Crack	Brick	Helical Ties	See Spec	Match Substrate	See A202 R.1 for Photos SHEET 611-R for detail	Assume 6 LOC
R-1	Displaced Stone	All masonry	Reset stone and point	N/A	N/A		
CP-1	Chips, holes, voids	All stone units	Cementitious patch repair	Limestone: Jahn M70; Granite: Jahn M160; TC/Brick: Jahn M100, Pointing Mortar Jahn M110	Match substrate	See SHEET A611-R	Assume 10 LOC
CP-2	Embedded metal objects	All masonry	Remove metal object; cementitious patch repair	Limestone: Jahn M70; Granite: Jahn M160; TC/Brick: Jahn M100, Pointing Mortar Jahn M110	Match substrate	Clean any rust prior to patching; See SHEET A611-R	See Elevations
CP-3	Spalled Bisque, Chips	Terracotta	Cementitious patch repair	Conproco Matrix System or cathedral stone system	Color & finish from Manuf selection	See SHEET A611-R; See Spec section 01 Unit Prices for lower cornice repair option	4 LOC / 40 SF
Masonry Cleaning							
RC	Atmospheric soils; biological, efflorescence	Granite, terracotta, Limestone, Brick	Restoration Cleaner	Cathedral Stone Bio cleaner, Light & Heavy Duty Cleaner, Efflorescence Remover	Approx. 30% of total surface area	Medium to be determined by testing; Pretreat areas before high-pressure water cleaning	1500 SF
OX	Atmospheric soils; biological, efflorescence	Limestone	After RC treatment, spot treatment of remaining stains	Cathedral Stone Oxidation Remover or Heavy Duty Cleaner	Approx. 10% of total surface area	Medium to be determined by testing; protect limestone and terracotta from cleaners; Apply after initial cleaning	200 SF
RR-1	Rust Staining	Granite, limestone, brick, Terracotta	Rust Remover	Cathedral Stone Rust Remover; Light & Heavy Duty Cleaner	N/A	Medium to be determined by testing; protect limestone and terracotta from cleaners;	900 SF
PR	Graffiti Paint	Granite, brick, limestone	Paint Remover	Cathedral Stone Graffiti Remover; Light & Heavy Duty Paint Stripper	N/A		


KEY NOTES - NEW WORK

- BALCONY**
- A-B FURNISH + INSTALL NEW GFRC + METAL RAILING EXT. BALCONY
- COPING**
- A-C.1 FURNISH + INSTALL METAL COPING AT EXISTING PARAPET
- A-C.2 FURNISH + INSTALL COPING LEAD T CAPS IN BETWEEN EXISTING LIMESTONE COPING STONES
- A-C.3 FURNISH + INSTALL LIMESTONE COPING AT EXISTING PARAPET SEE MASONRY SCHEDULE; V.I.F. EXTENT OF AREA/LOCATION FOR REPLACEMENT
- DOOR**
- A-D.1 FURNISH + INSTALL NEW METAL DOORS AND FRAMES. SEE DOOR SCHED.
- A-D.2 (E) DOOR TO REMAIN
- A-D.3 CONTRACTOR TO FURNISH AND INSTALL DOOR HARDWARE, DISABLE OPENING FUNCTIONS AND LOCK. KEYPED OPENINGS ONLY UNTIL EXTERIOR STAIRS ARE INSTALLED. CONTRACTOR PROVIDE VISUAL SIGNALS, CAUTION TAPE, ETC.) AND TEMPORARY PHYSICAL BARRIER AT DOOR ON INSIDE TO PREVENT OPENING WITHOUT AUTHORIZATION. CONFIRM AND COORDINATE WITH OWNER
- LIGHT FIXTURES**
- (FOR REFERENCE ONLY - LIGHT FIXTURES TO BE FURNISHED AND INSTALLED IN PACKAGE 2)
- A-L.1 FURNISH + INSTALL LIGHT FIXTURES UNDER BALCONY
- A-L.2 FURNISH + INSTALL UPWASH LIGHT FIXTURES (BELOW BLDG NAME & AT METAL PANELS)
- RAIN LEADERS**
- A-R.1 FURNISH + INSTALL RAIN LEADERS
- A-R.2 FURNISH + INSTALL SCUPPERBOX
- MASONRY**
- A-M MASONRY INFILL AT FORMER DOOR LOCATIONS - SEE DOOR SCHED
- A-MLI REPAIR TERRACOTTA LINTEL. PIN SECTIONS OFF-SITE. REINSTALL ON NEW STL ANGLE LITELS. SEE UNIT PRICES FOR ALTERNATE METHODS OF REPAIR
- LOUVER**
- A-ML.1 FURNISH + INSTALL METAL LOUVER IN DORMER WINDOW OPENING
- METAL PANEL**
- A-M.P FURNISH + INSTALL DECORATIVE METAL PANELS ANCHORED TO EXIST. MASONRY INFILL
- ROOF**
- A-R.1 FURNISH + INSTALL ROOF LADDER AND CAGE
- A-R.2 FURNISH + INSTALL NEW ROOF
- A-R.3 FURNISH + INSTALL ROOF HATCH
- A-R.4 FURNISH + INSTALL METAL CLAD DORMER WALLS AND NEW DORMER ROOF
- STRUCTURAL**
- A-S.1 CRACK REPAIR - SEE STRUCTURAL
- A-S.2 STEEL LINTEL REPLACEMENT - SEE STRUCTURAL
- STAIR**
- A-ST.1 LOCATION OF REMOVED CONCRETE STAIR - PATCH AND REPAIR
- A-ST.2 PROVIDE TEMPORARY WOOD CONSTRUCTION STAIR - DO NOT ATTACH TO BUILDING. LEAVE IN OPERABLE, SAFE CONDITION AT END OF PROJECT FOR USE BY OTHERS.
- WINDOWS**
- A-W.1 FURNISH + INSTALL NEW METAL WINDOWS
- A-W.2 FURNISH + INSTALL NEW METAL SASH + METAL CLADDING OVER EXIST. WOOD FRAMES
- A-W.3 FURNISH + INSTALL SECURITY SCREENING AT WINDOWS

GENERAL NOTES:

- SEE A631-R.1 FOR ROOF DETAILS
- SEE A632-R.1 FOR LADDER AND DORMER DETAILS
- REMOVE EXISTING WINDOWS AND INSTALL ALL NEW WINDOWS. SEE WINDOW SCHEDULE A602-R.1
- MASONRY REPAIRS, THROUGHOUT. SEE ALSO SHEET A612-R.1 AND STRUCTURAL DRAWINGS.
- PATCH AND REPAIR ALL HOLES LEFT FROM WINDOW SCREENS AFTER REMOVAL
- 100% CLEANING WITH RESTORATION CLEANER
 - A - HEAVILY SOILED AREAS
 - B - SKY-FACING SURFACES AT CORNICES, LITELS, AND BANDING.
 - C - PARAPETS - BOTH SIDES
- REMOVE ALL BIOLOGICAL GROWTH.
- REMOVE RUST STAINING.
- 100% REPOINT GRANITE BASE, BRICK, LIMESTONE & TERRACOTTA TO REMAIN. AT LIMESTONE COPING, TAKE OUT EXISTING MORTAR AND REPOINT AT BED JOINTS AND CROSS JOINTS. AT EXTERIOR BED JOINT AND FRONT, TOP, AND BACK JOINTS, HOLD MORTAR BACK APPROX 1/2" AND INSTALL BACKER AND SEALER.
- 100% REPLACE UPPER CORNICE - SEE SHEET A611-R.1 AND STRUCTURAL DRAWINGS.
- REPLACE TERRACOTTA BALCONY AND RAILING - SEE SHEET A611-R AND STRUCTURAL DRAWINGS FOR EXTENT OF REPOD STEEL AND MASONRY REMOVAL AND PROVIDE REPLACEMENT MASONRY TO MATCH EXISTING.
- INFILLED WINDOWS 206, 206, 207
 - A - AFTER MASONRY CLEANING, PREP CAST STONE SURFACE, APPLY MINERAL SILICATE COATING, INSTALL DECORATIVE MTL PANEL, MECHANICALLY ATTACHED.
 - B - REFER TO DETAILS ON SHEET A601-R.1
- INSTALL NEW RAIN LEADERS
- AT AREAS OF FERROUS METAL WHERE REINFORCEMENT IS EXPOSED TO REPAIR AREA OR REPAIRS ARE ADJACENT TO FERROUS METAL JAMBS, LITELS, OR ANCHORING SYSTEMS, PREPARE METAL SURFACE AND APPLY COATING: B.O.D. COROTECH V160 SURFACE TOLERANT EPOXY MASTIC.
- CURVED COPING AT SOUTH WEST ROOF, NORTH COPING: REPLACE WITH NEW IN KIND.
- AT ALL TERRACOTTA/STONE COPING TO REMAIN U.N.O., REMOVE MEMBRANE COATING.
- NORTH CHIMNEY - CRACK REPAIR AND CHIMNEY STABILIZATION, REPOINT, RESET LIMESTONE CAP. REFER TO SHEET AD105-R FOR ADDITIONAL INFORMATION.
- ALL EXPOSED STEEL LITELS SHALL BE TREATED WITH COLD GALVANIZED PAINT AND REVIEWED BY STRUCTURAL ENGINEER PRIOR TO RE-INSTALLATION OF NEW WINDOWS. REFER TO STRUCTURAL DRAWINGS.

MASONRY REPAIR GRAPHIC KEY

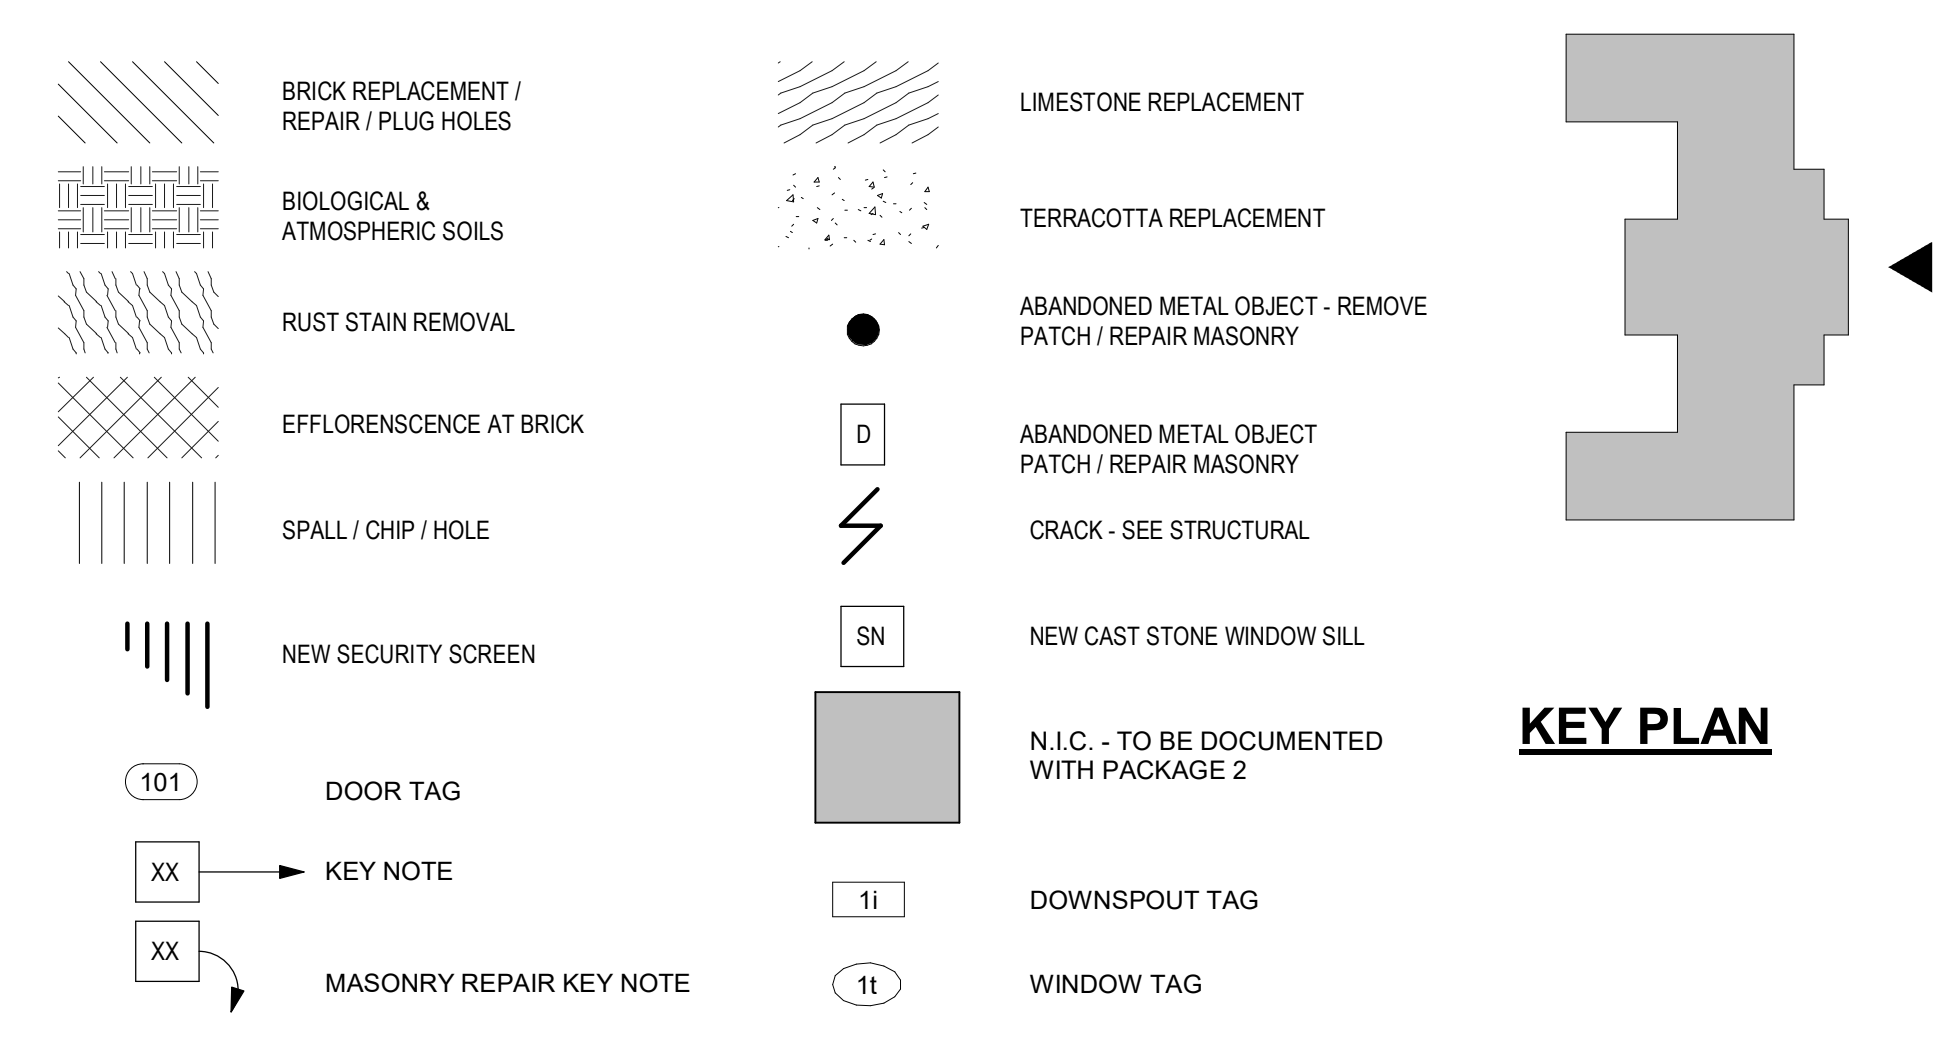

KEY PLAN

REVISIONS

ISSUE	DATE	DESCRIPTION
1	5/15/23	ISSUE FOR PERMIT
2	5/19/23	ADDENDUM 1



REVIEWED BY:

PROJECT COORDINATOR

SEALS



KELLY MAIELO ARCHITECTS
1420 Walnut Street, 15th Floor
Philadelphia, PA 19102
www.kmarchitects.com

LANDSCAPE ARCHITECT:
Salt Design Studio
161 Leverington Ave, Suite 1005
Philadelphia PA 19127
www.saltdesignstudio.com

STRUCTURAL / M.E.P. / F.P. / SITE CIVIL ENGINEERS:
Pennoni Associates
1900 Market Street Suite 300
Philadelphia PA 19103
www.pennoni.com

LEED CONSULTANT:
Verde Architecture Consulting
1635 Market Street Suite 1600
Philadelphia PA 19103


CITY OF PHILADELPHIA
REBUILD / PHILADELPHIA PARKS AND RECREATION

1515 ARCH STREET
5TH FLOOR, ONE PARKWAY BUILDING

PHILADELPHIA PENNSYLVANIA

PROJECT TITLE
KINGSSESSING RECREATION
CENTER BUILDING AND SITE
IMPROVEMENTS - PACKAGE 1

KEY PLAN

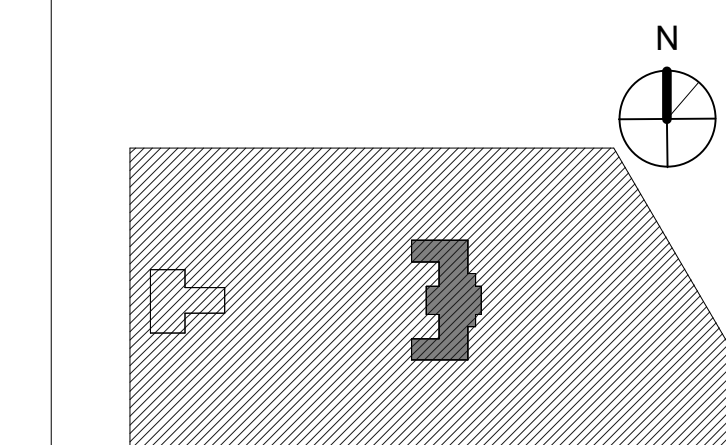

ROOF DETAILS

PROJECT NO.

DRAWING NO.

21070

A631-R.1

DATE

05/15/23

SCALE

As Indicated


DRAWN BY:

AF


CHECKED BY:

DB


NOTE: ALL DIMENSIONS AND CONDITIONS SHALL BE VERIFIED BY THE CONTRACTOR AT THE SITE BEFORE PROCEEDING WITH THE WORK.

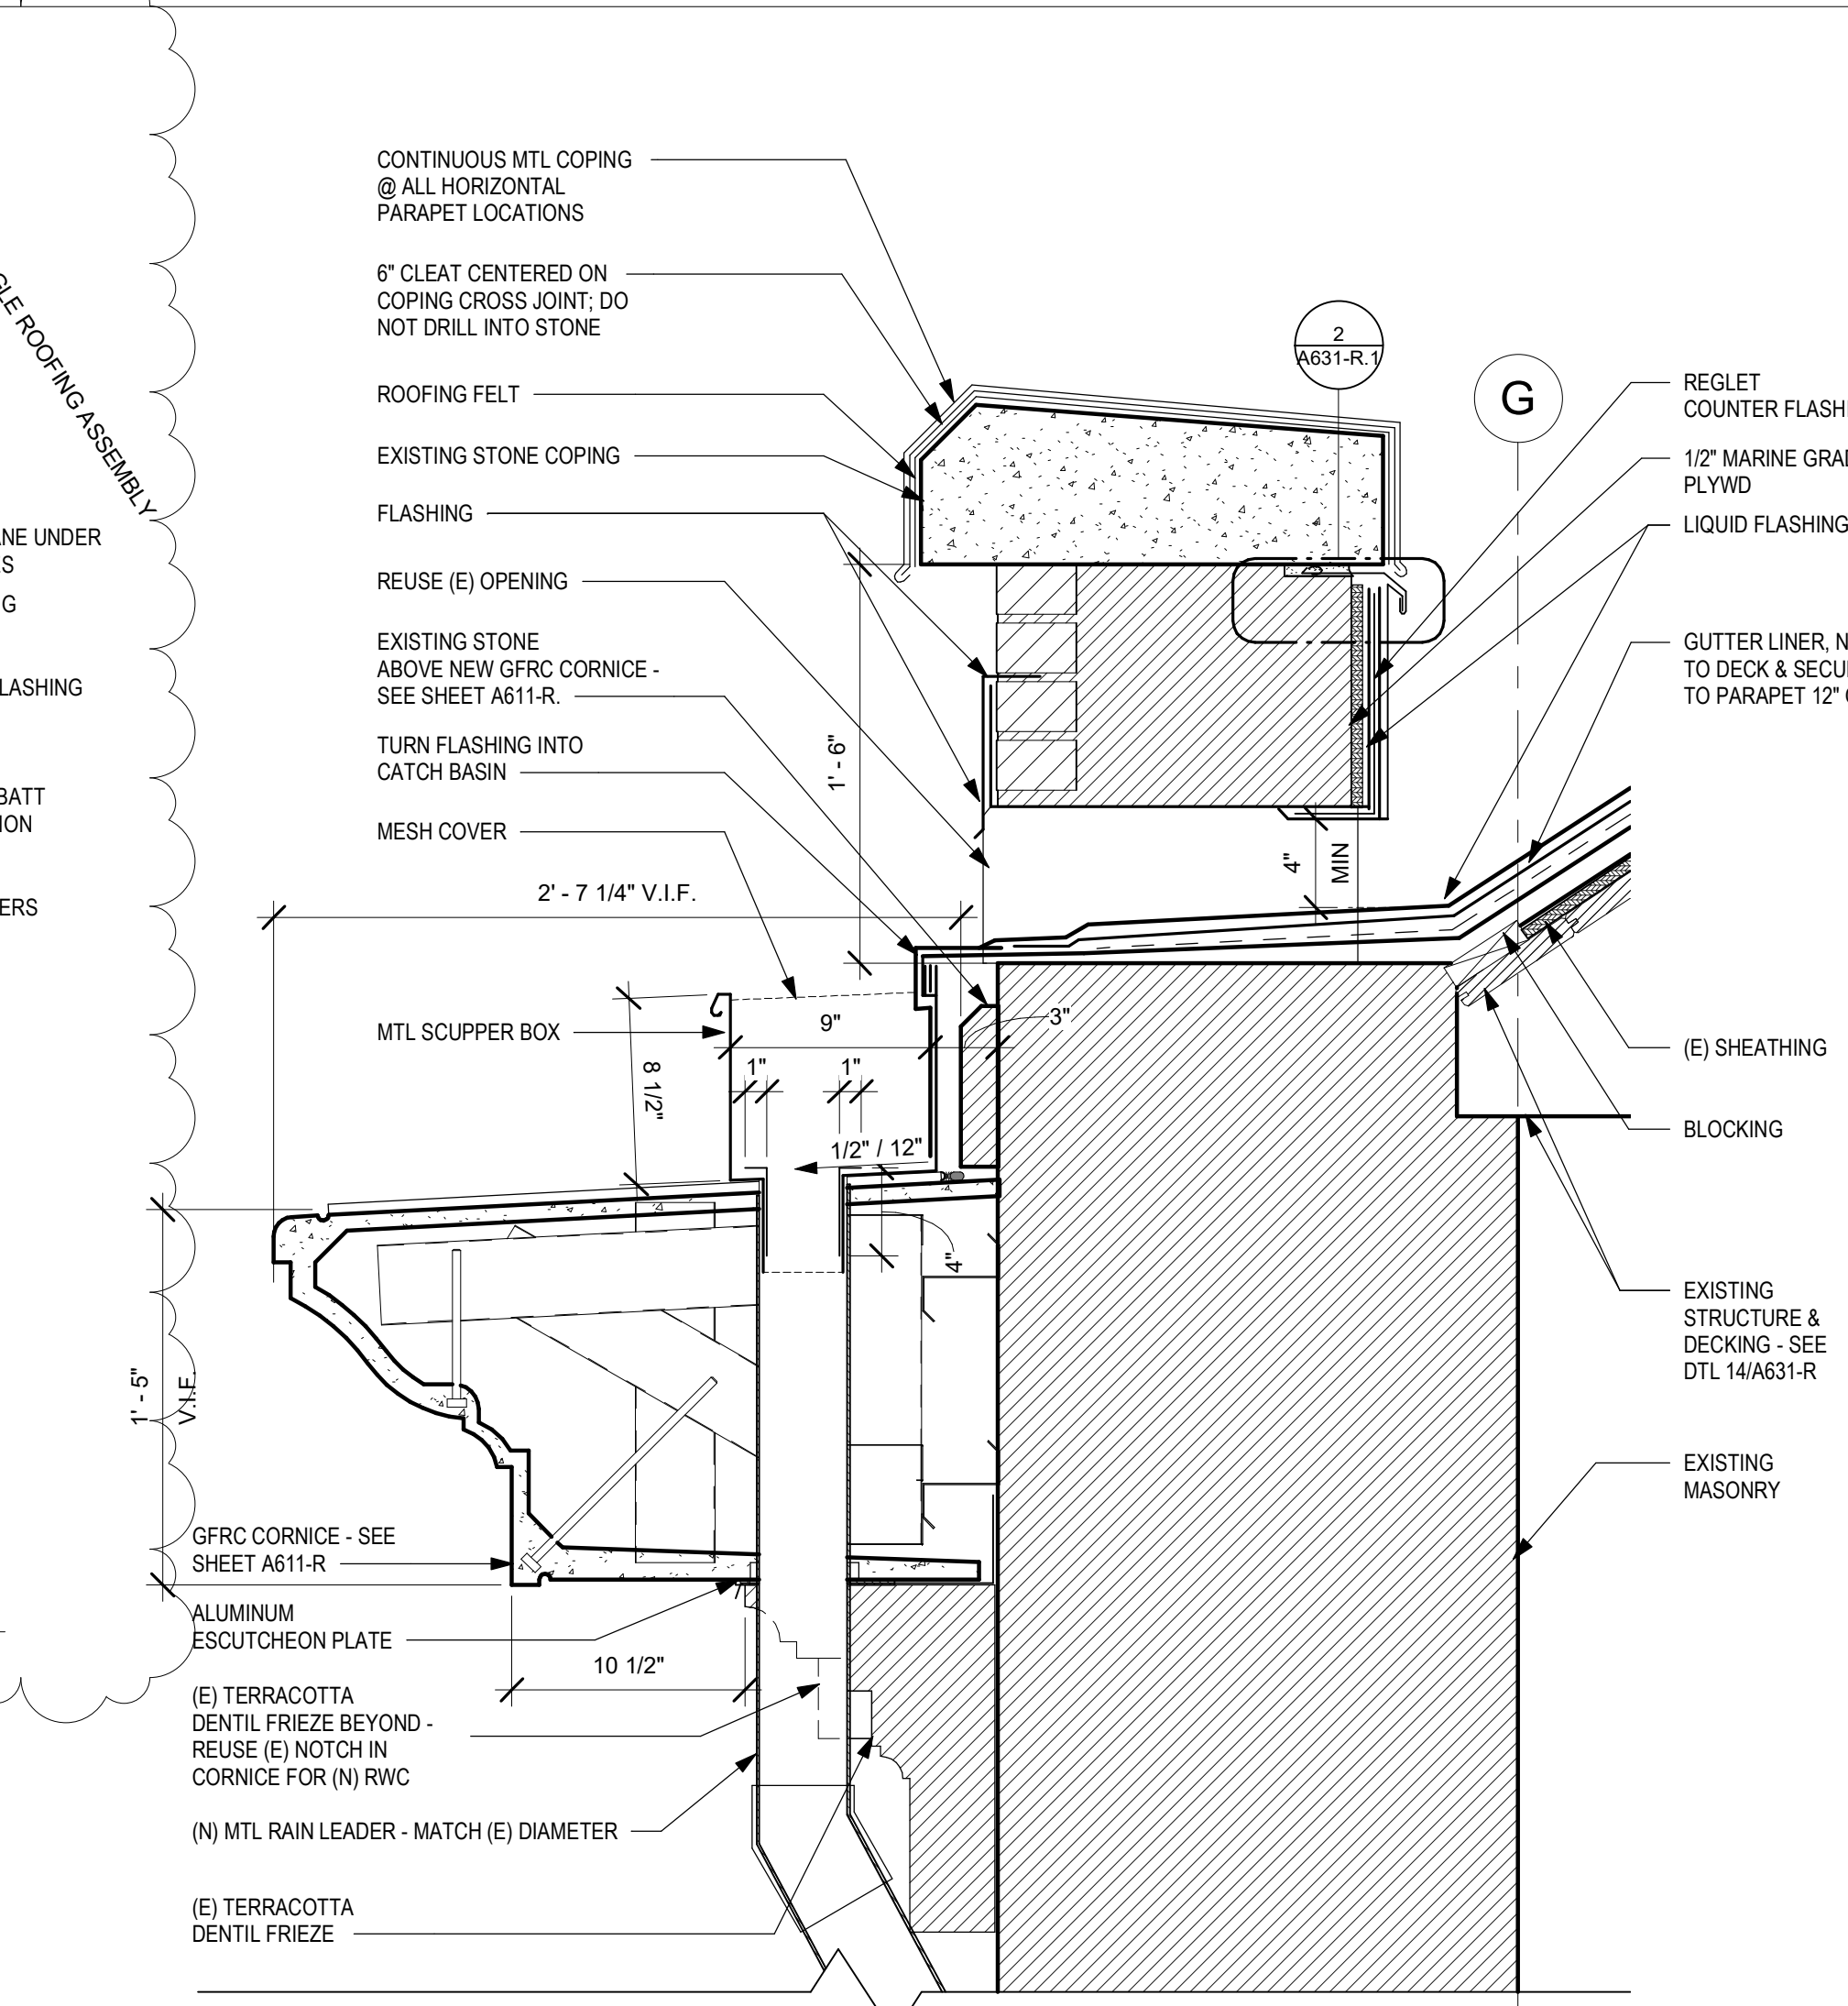


4 DETAIL @ SCUPPER AND HORIZONTAL PARAPET
1 1/2" = 1'-0"

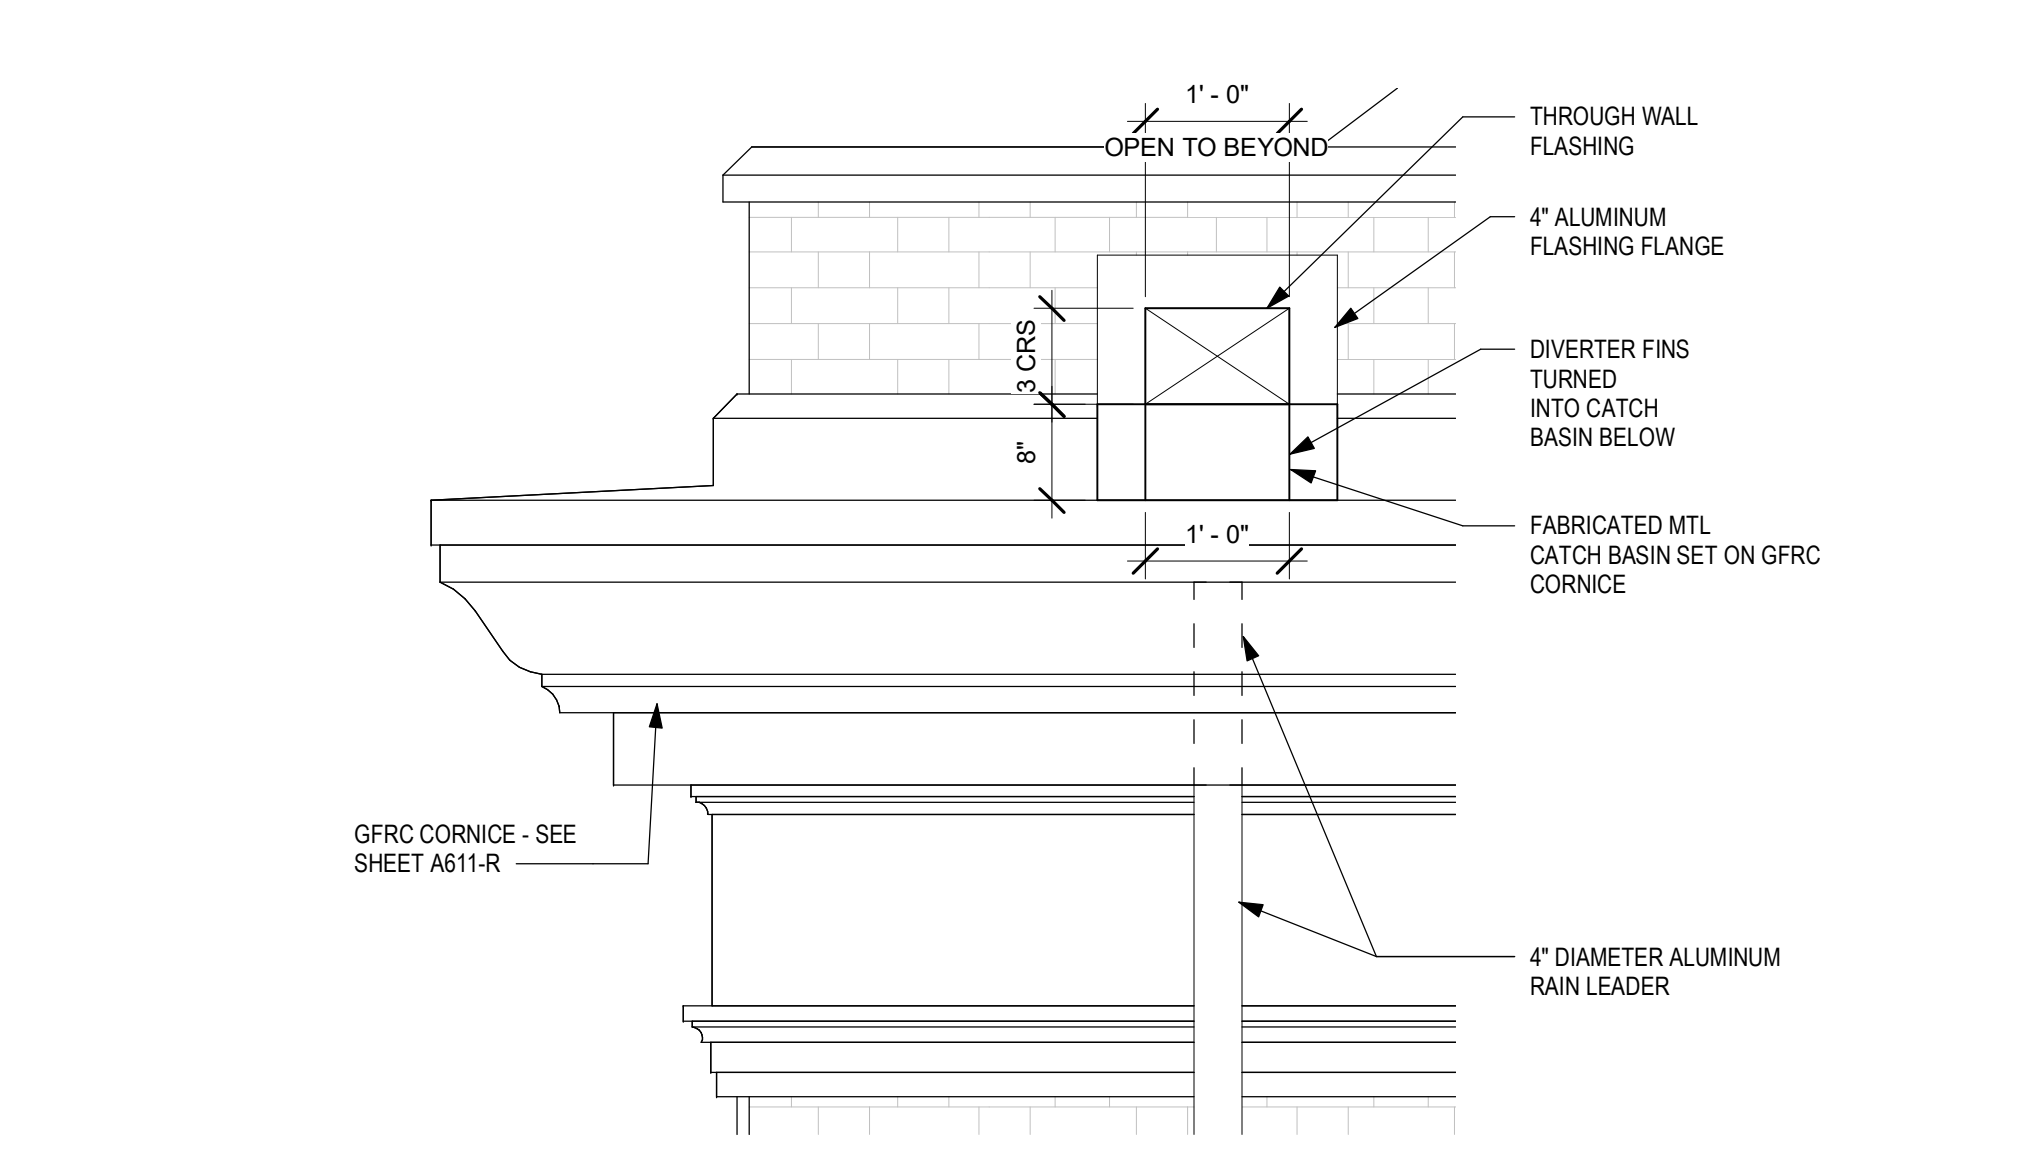


3 SCUPPER ELEVATION
3/4" = 1'-0" REFERENCE DETAIL: 2 / A201-R.1

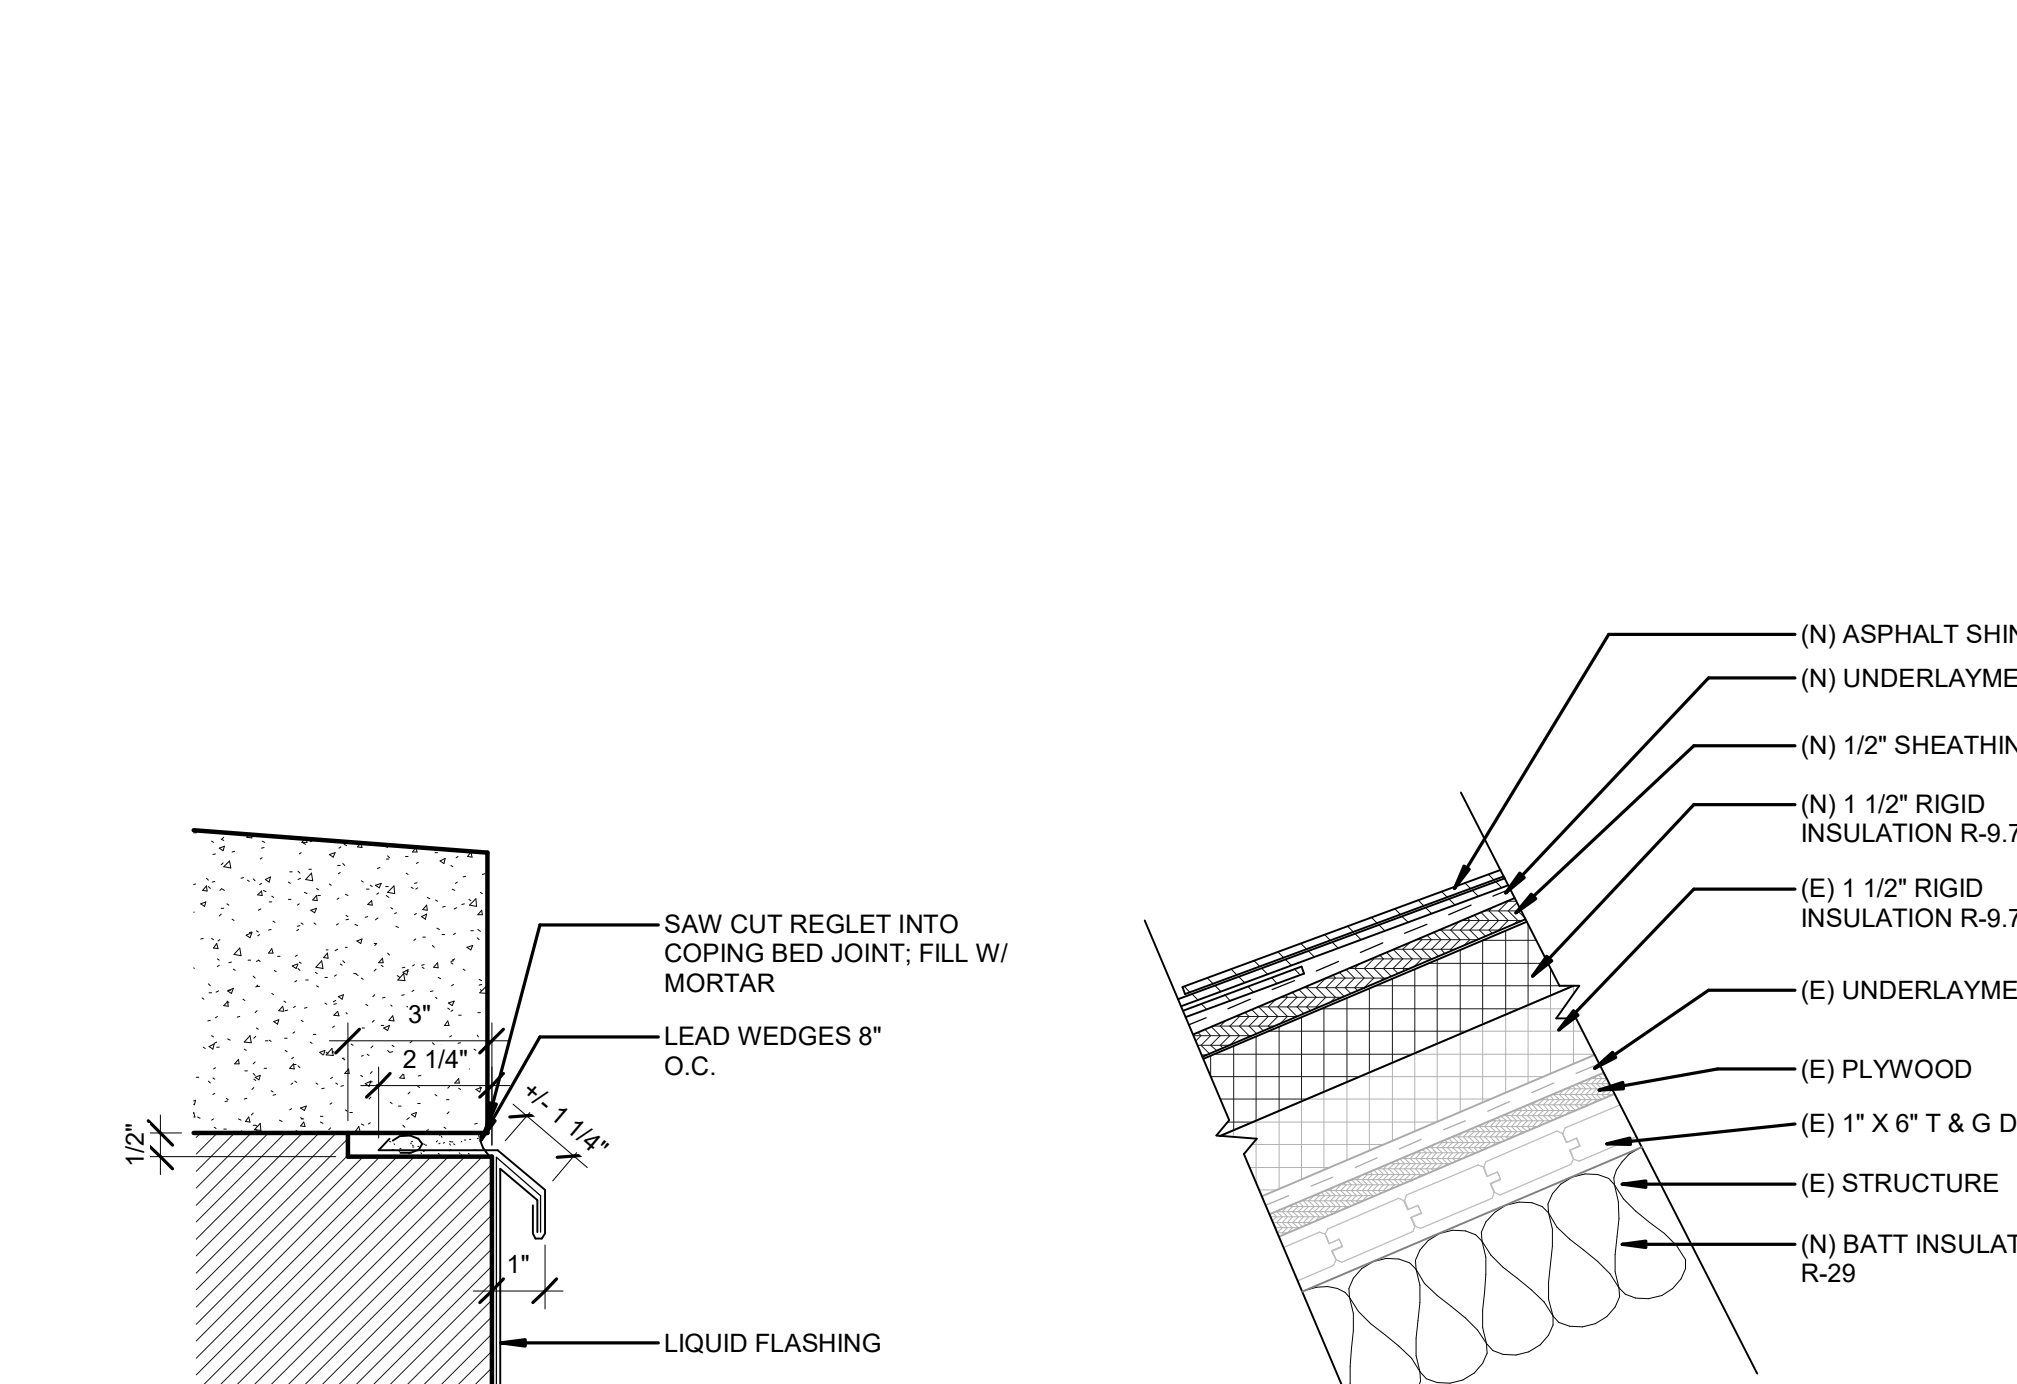


2 TYP REGLET DTL
3" = 1'-0"

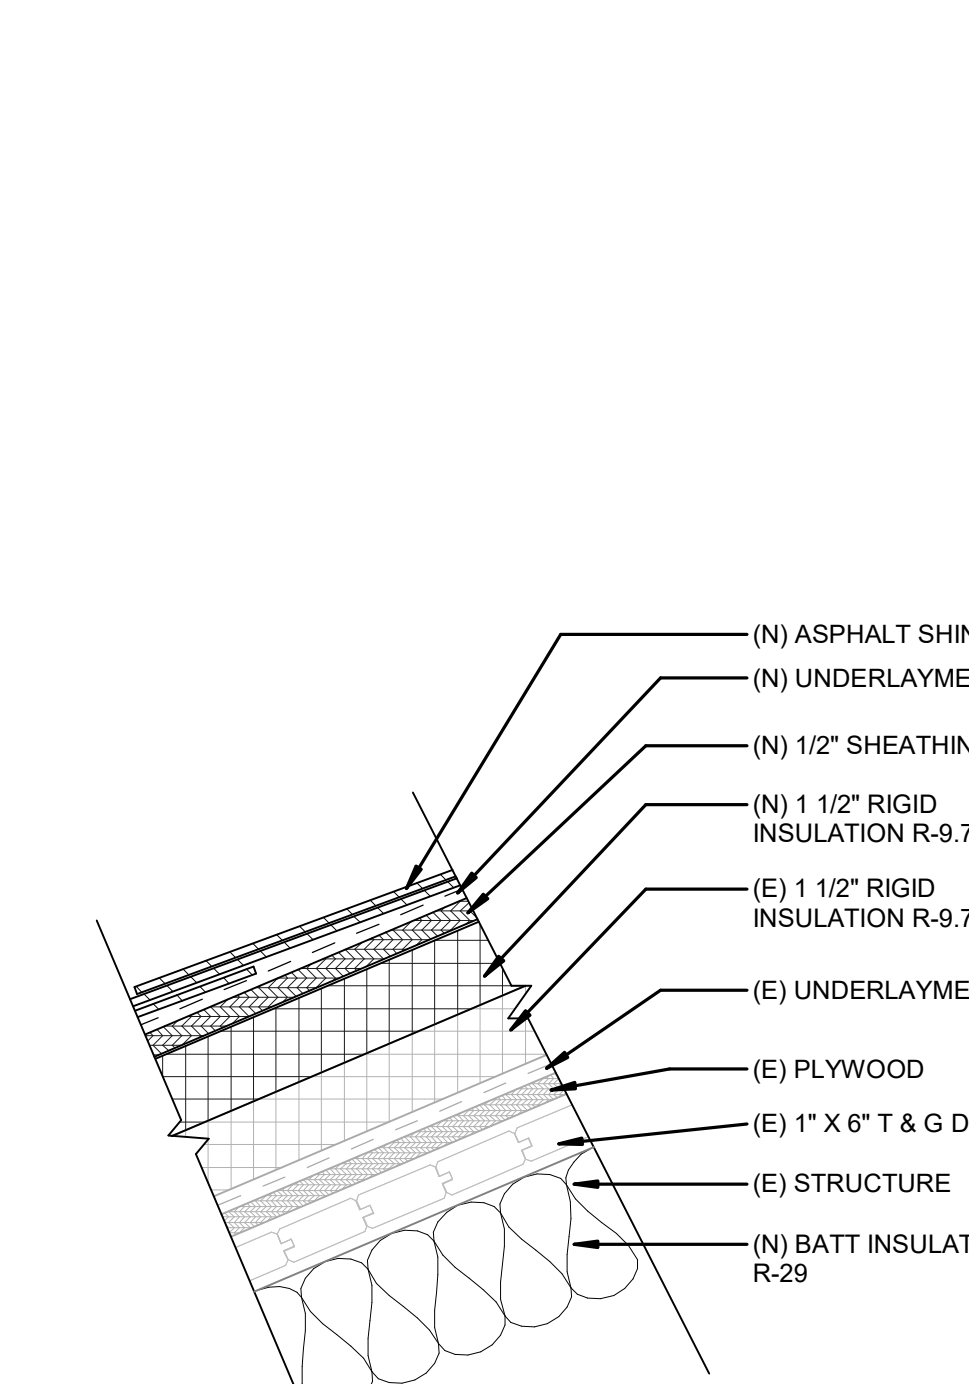


1 TYP ROOF ASSEMBLY - SHINGLE
3" = 1'-0"

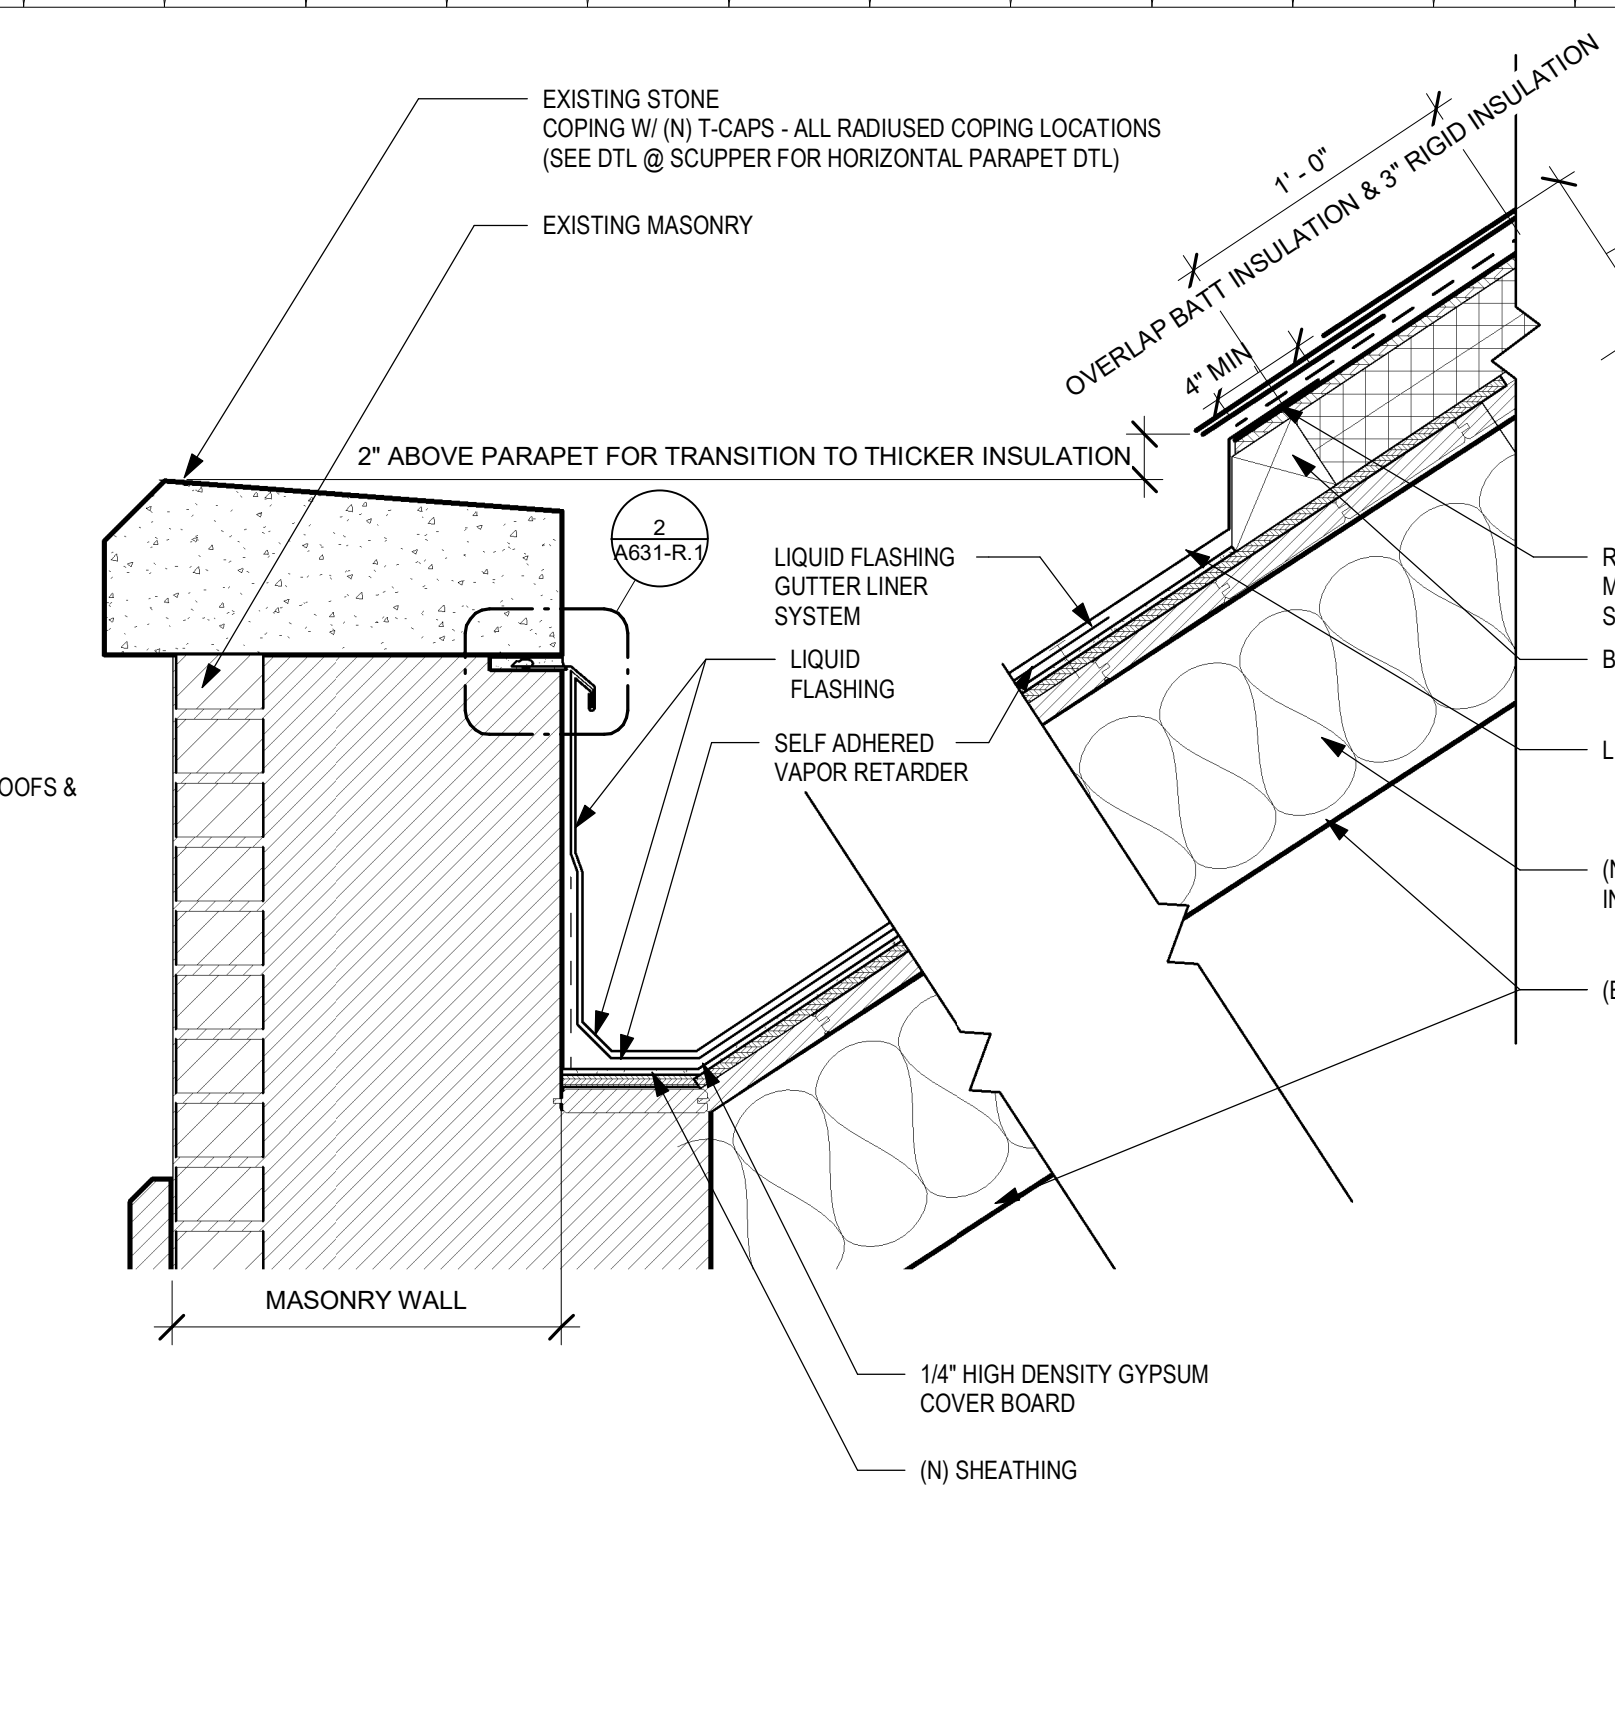


5 DETAIL @ HIGH ROOF
1 1/2" = 1'-0" REFERENCE DETAIL: 1 / A104-R.1

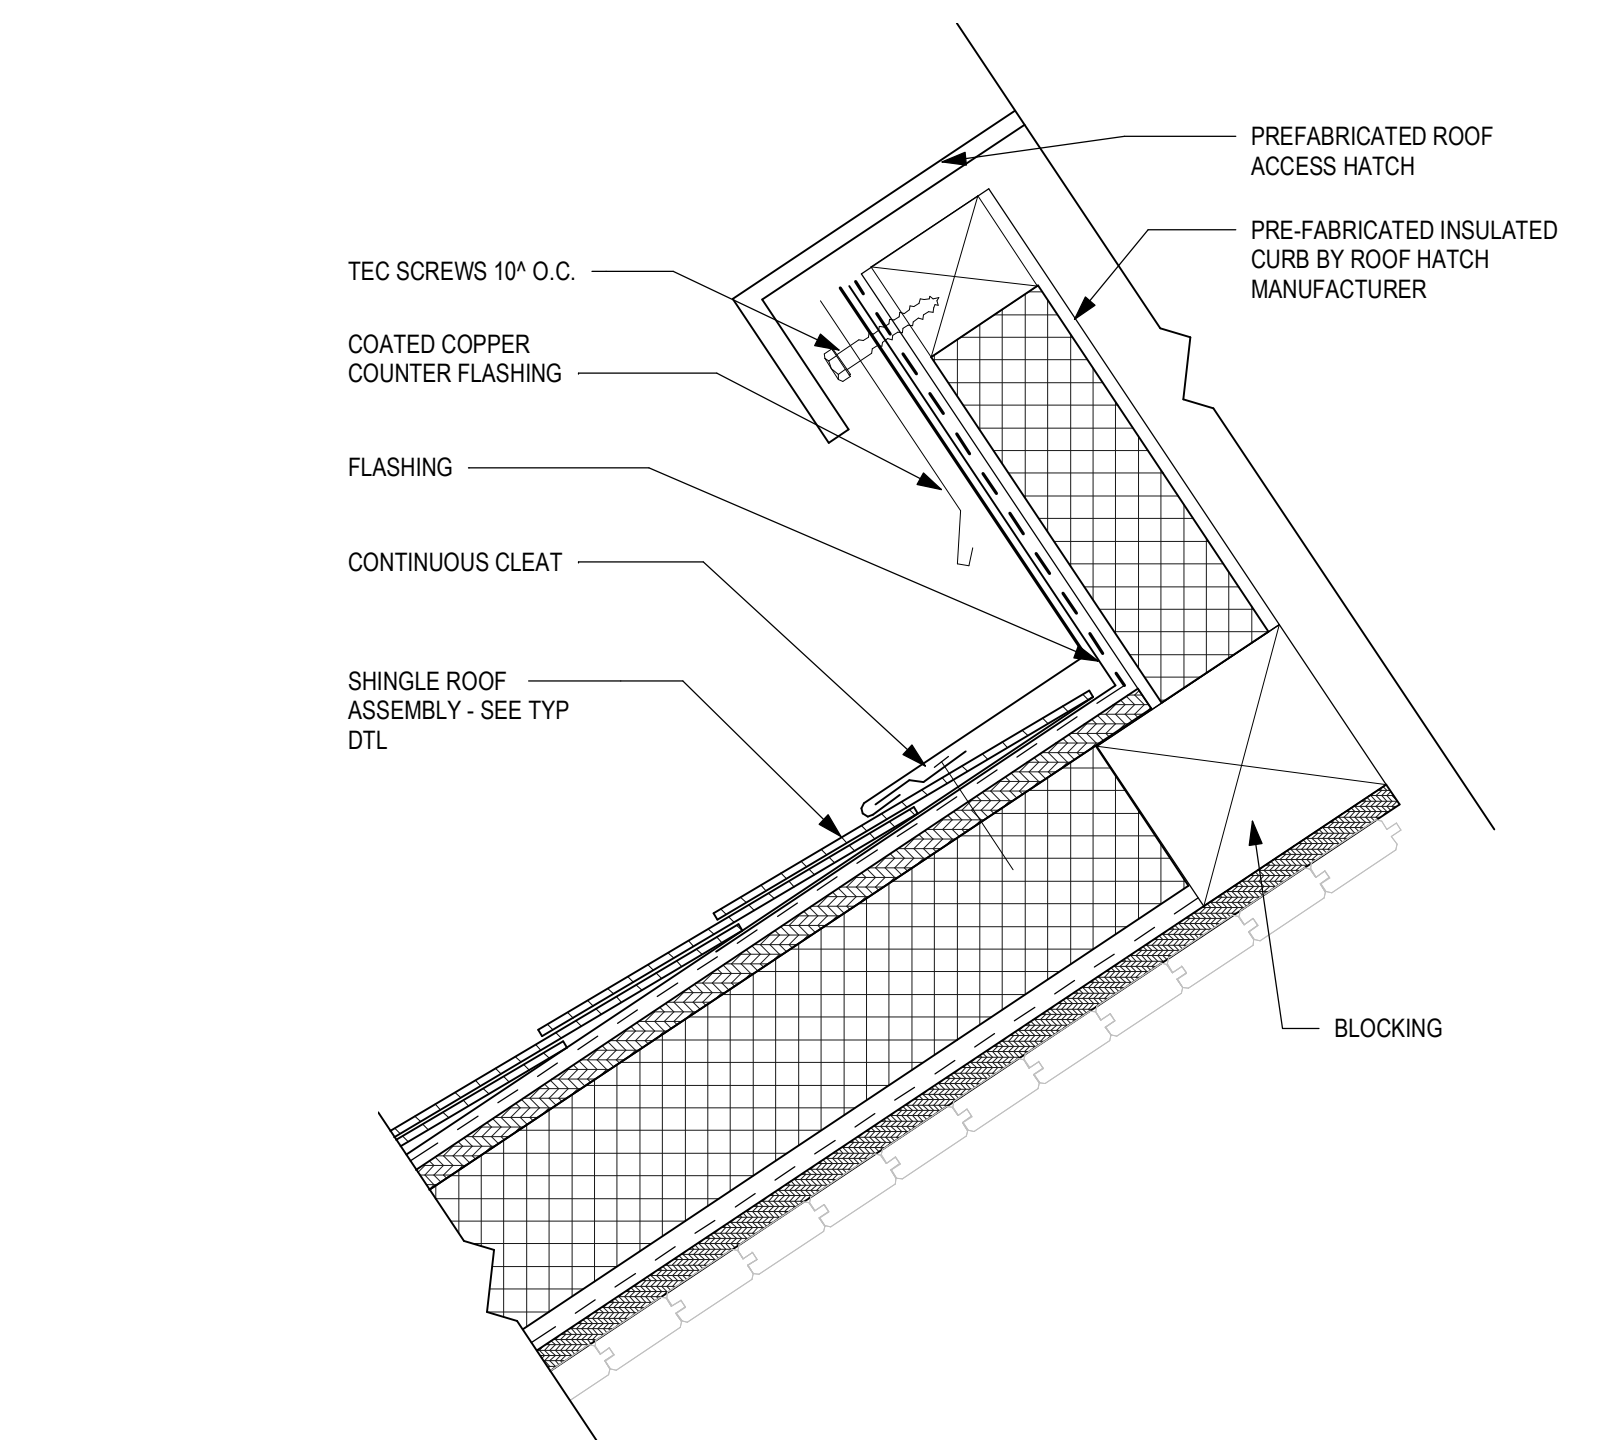


8 DETAIL THROUGH ROOF HATCH ACCESS
3" = 1'-0" REFERENCE DETAIL: 1 / A104-R.1

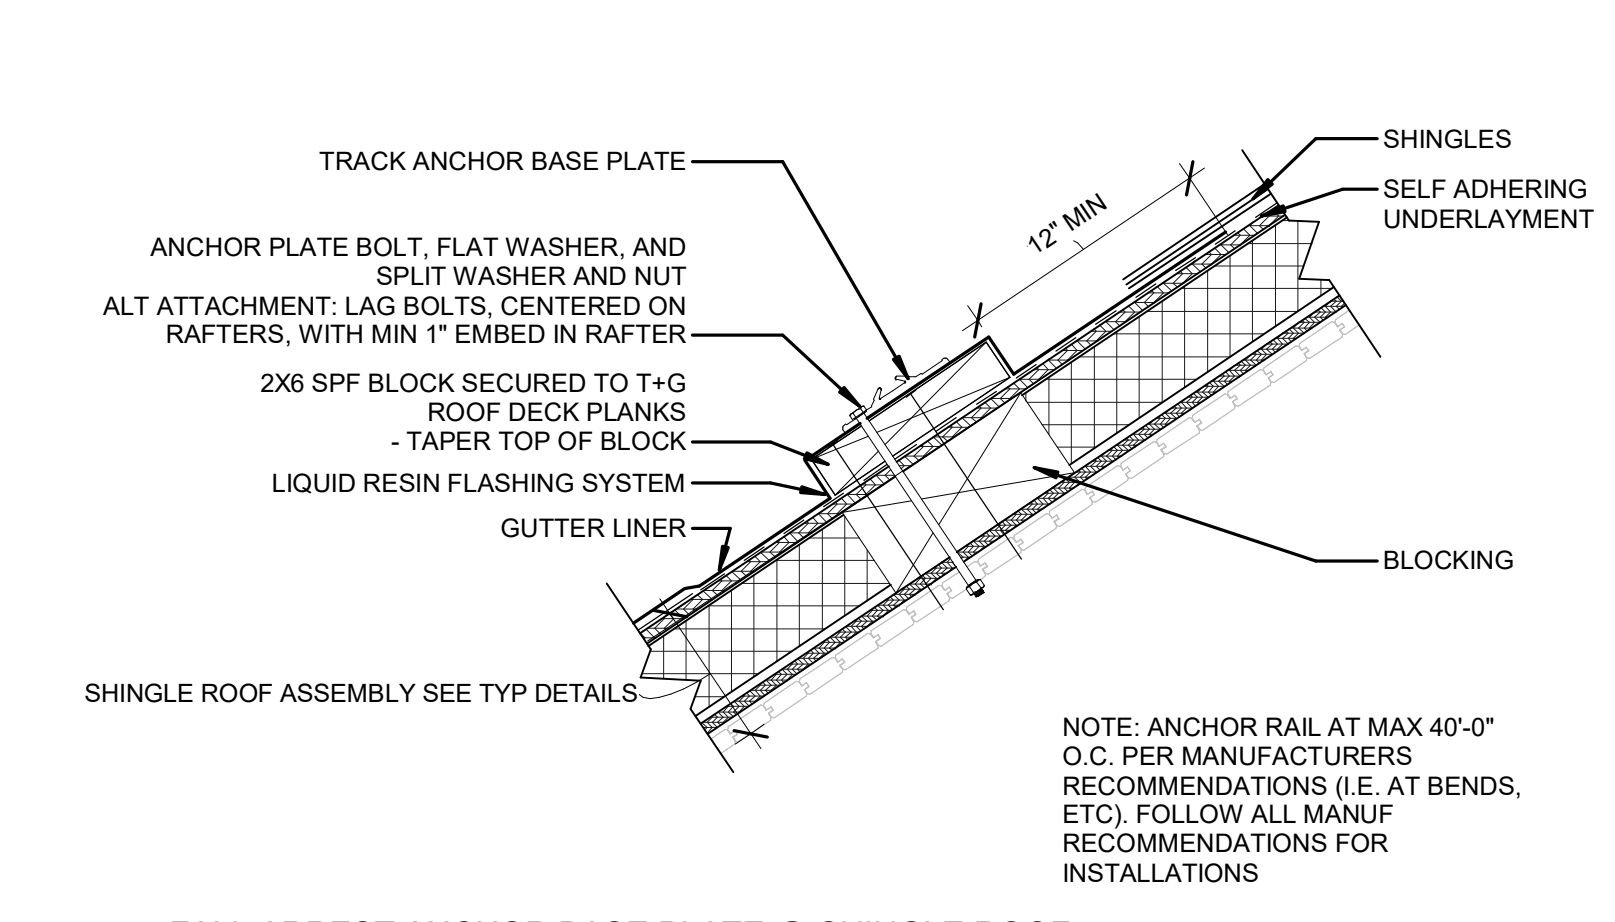


9 FALL ARREST ANCHOR BASE PLATE @ SHINGLE ROOF
1 1/2" = 1'-0"

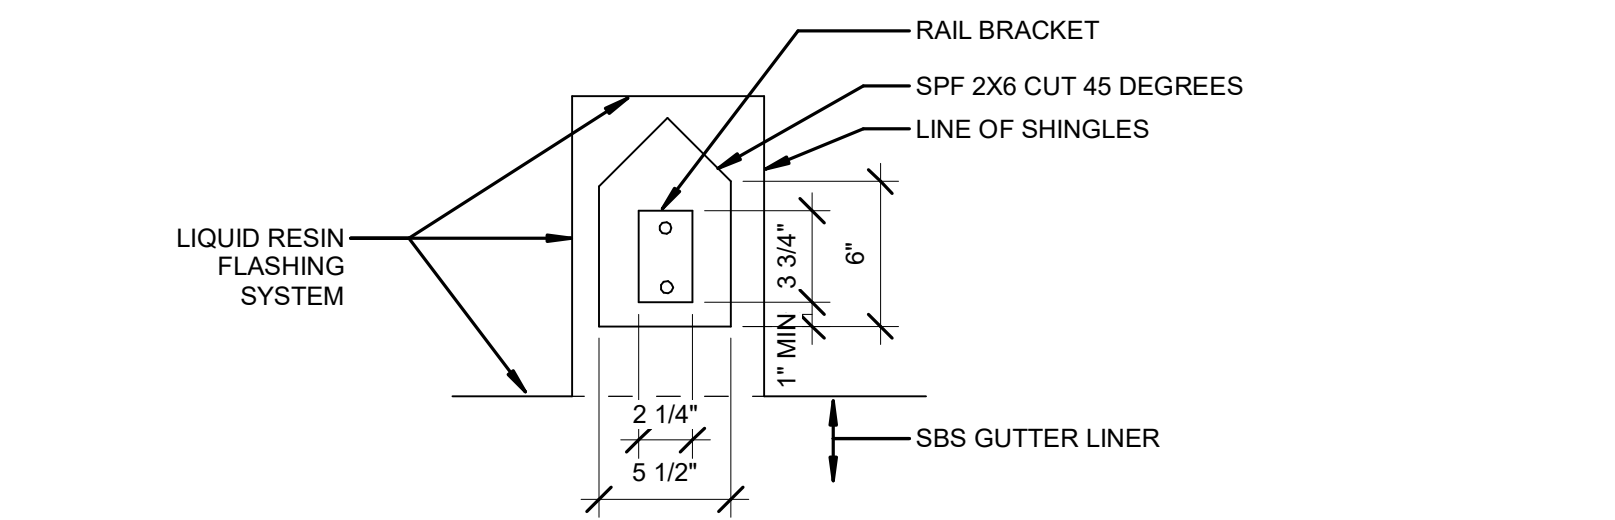


10 PLAN VIEW OF SLIDING RAIL BRACKET @ FALL ARREST SYSTEM
1 1/2" = 1'-0"

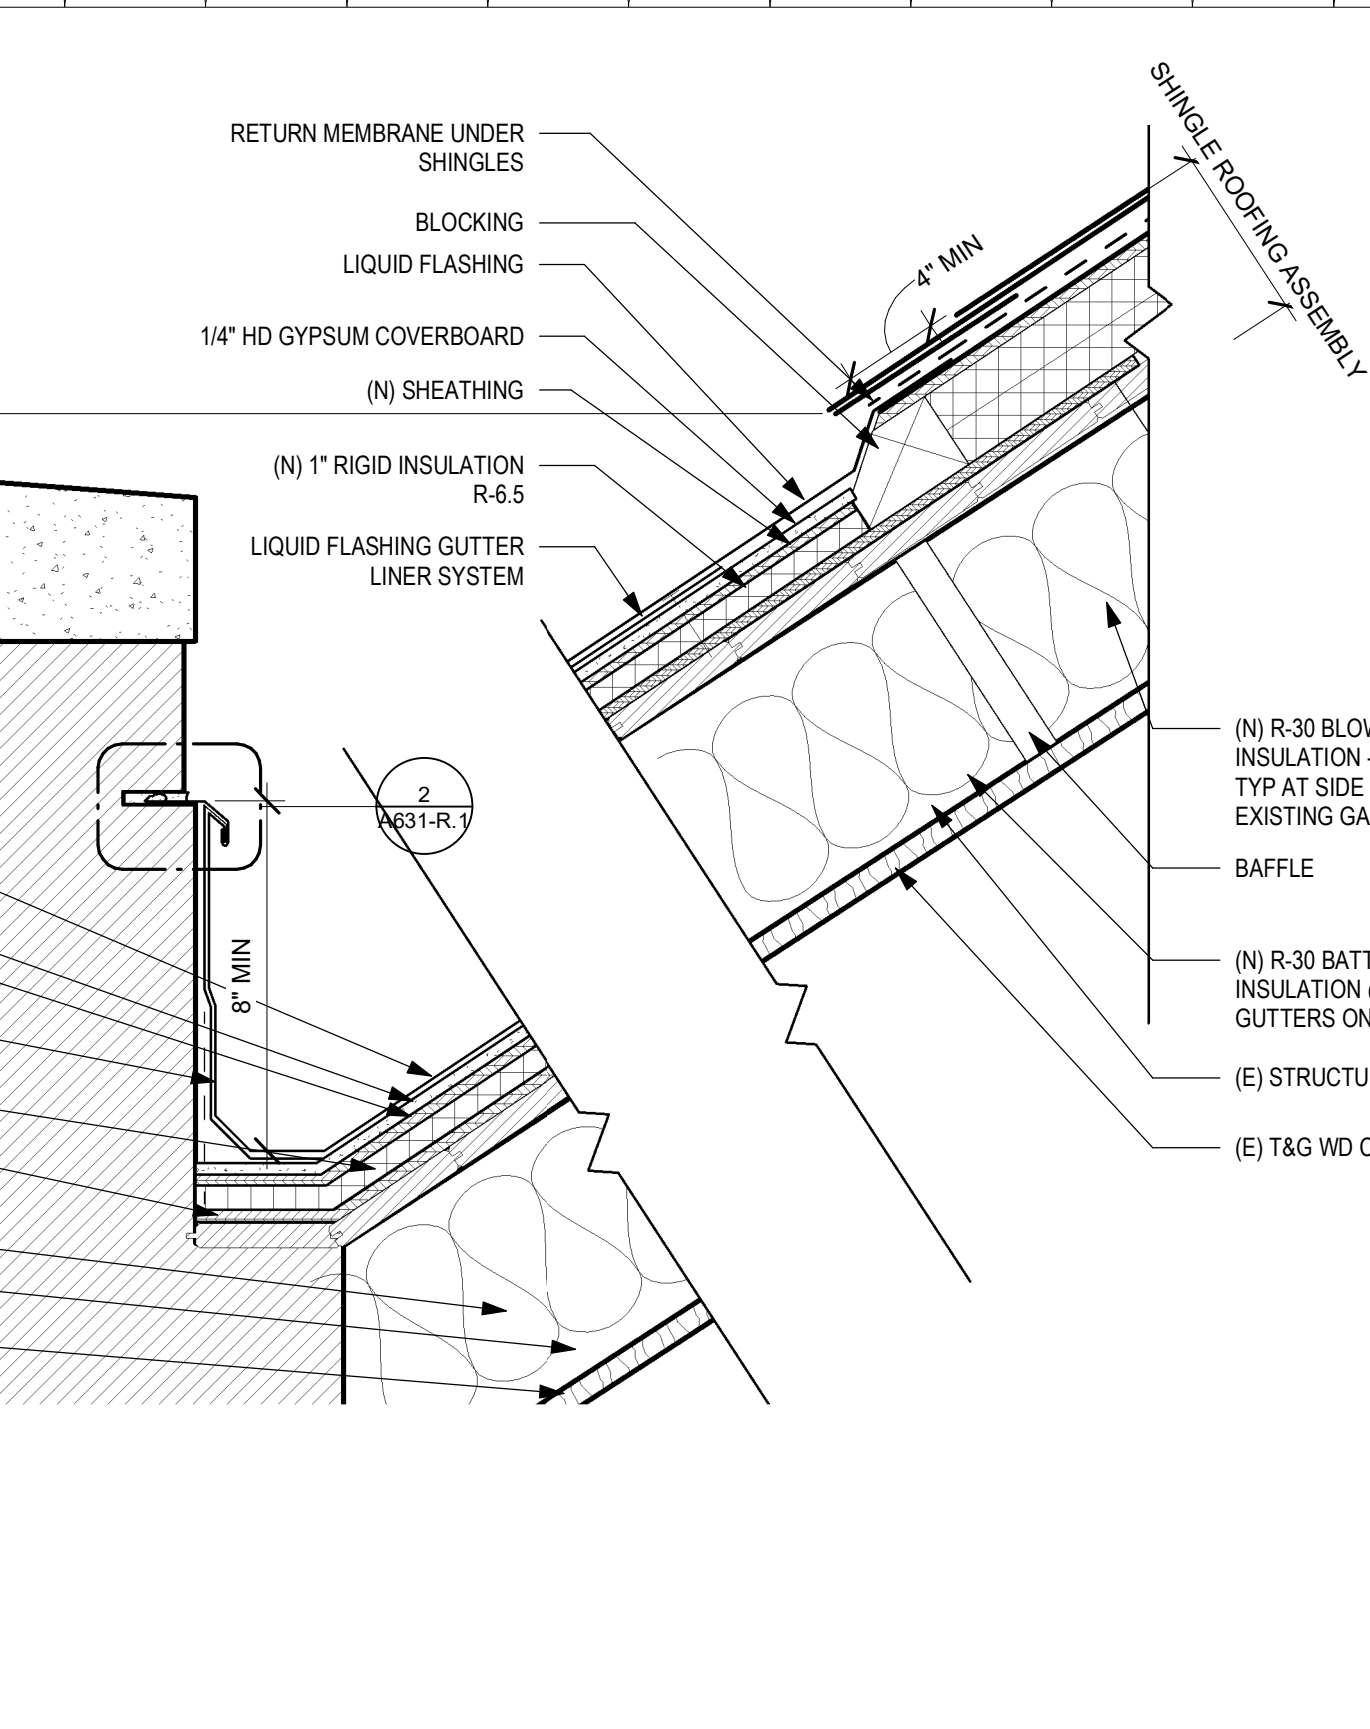


6 DETAIL @ LOW ROOF
1 1/2" = 1'-0"

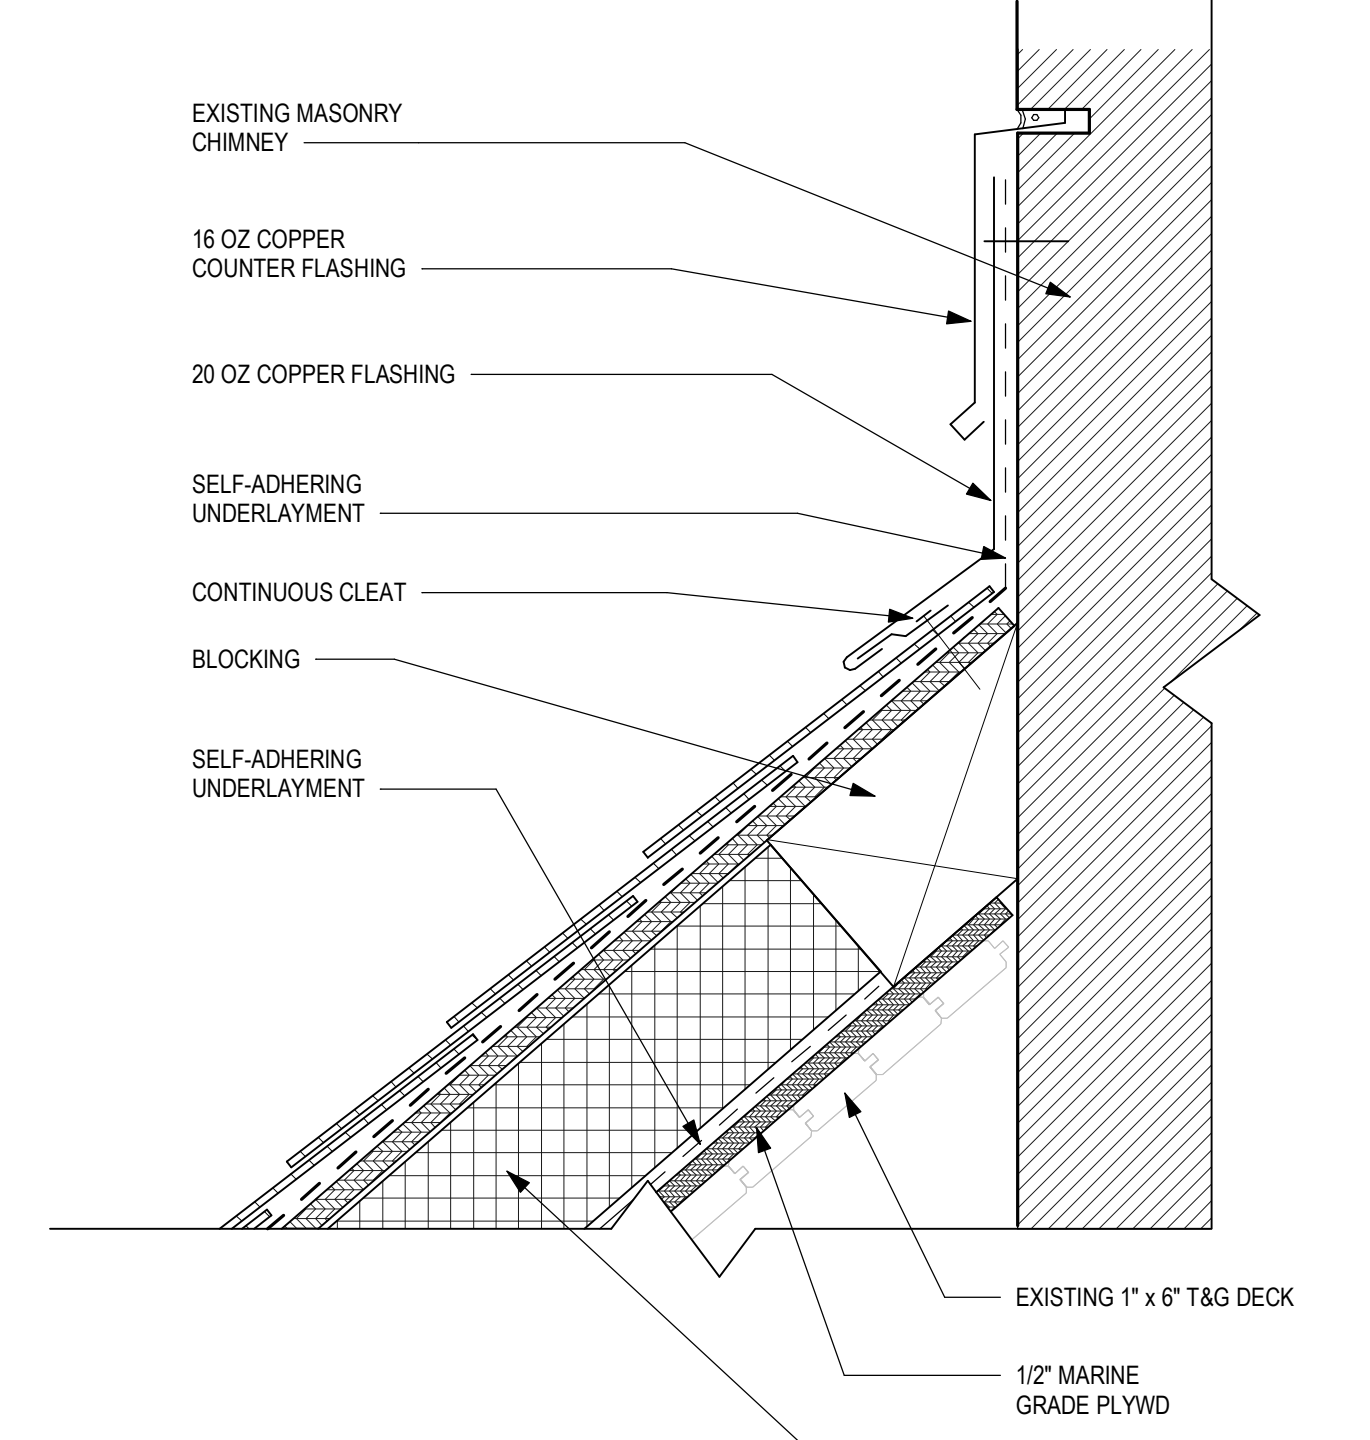


7 Roof Detail @ SIDE WALL FLASHING
3" = 1'-0" REFERENCE DETAIL: 1 / A104-R.1

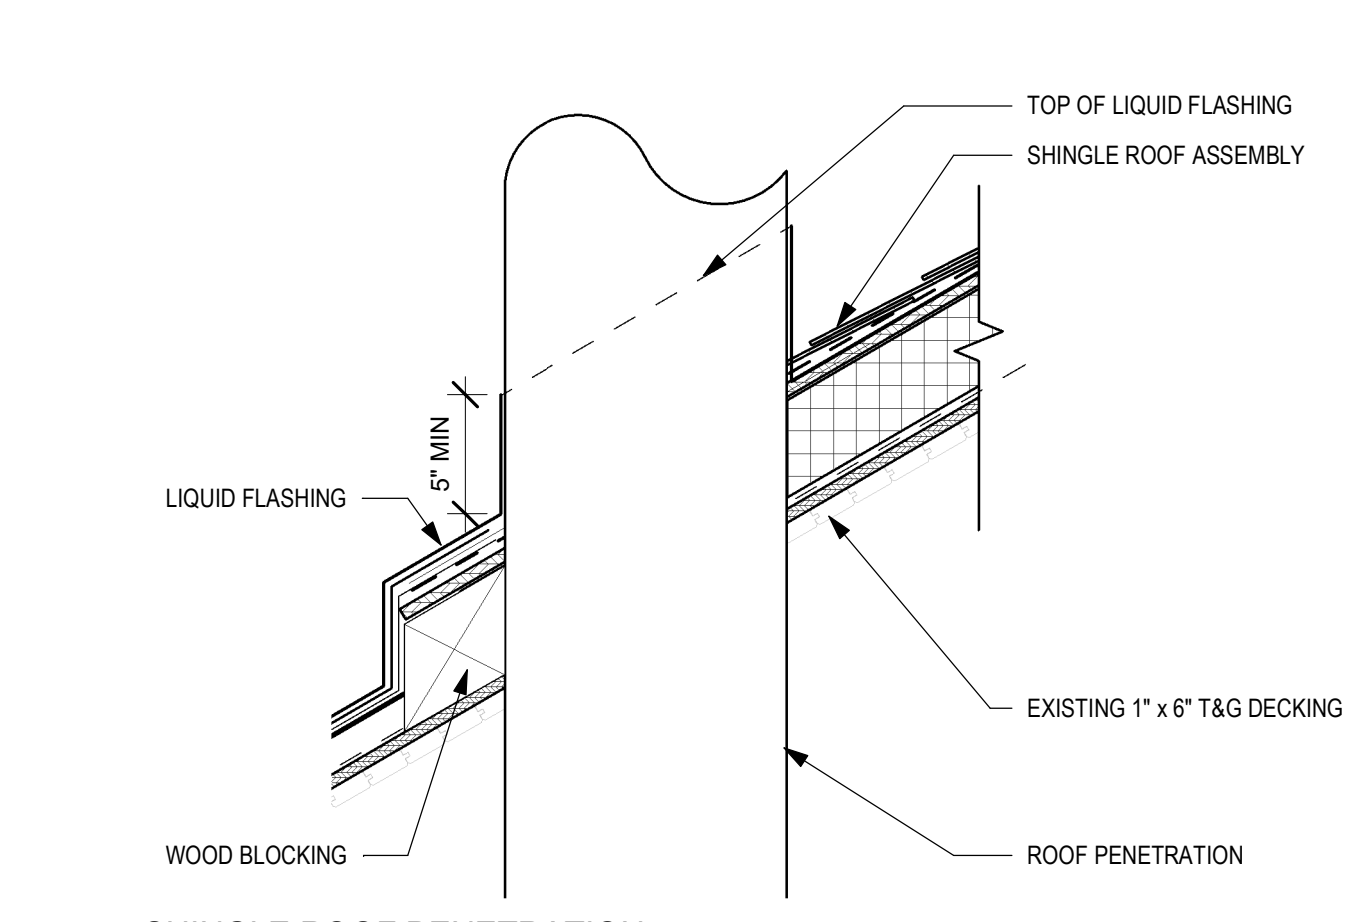

12 SHINGLE ROOF PENETRATION
1 1/2" = 1'-0"

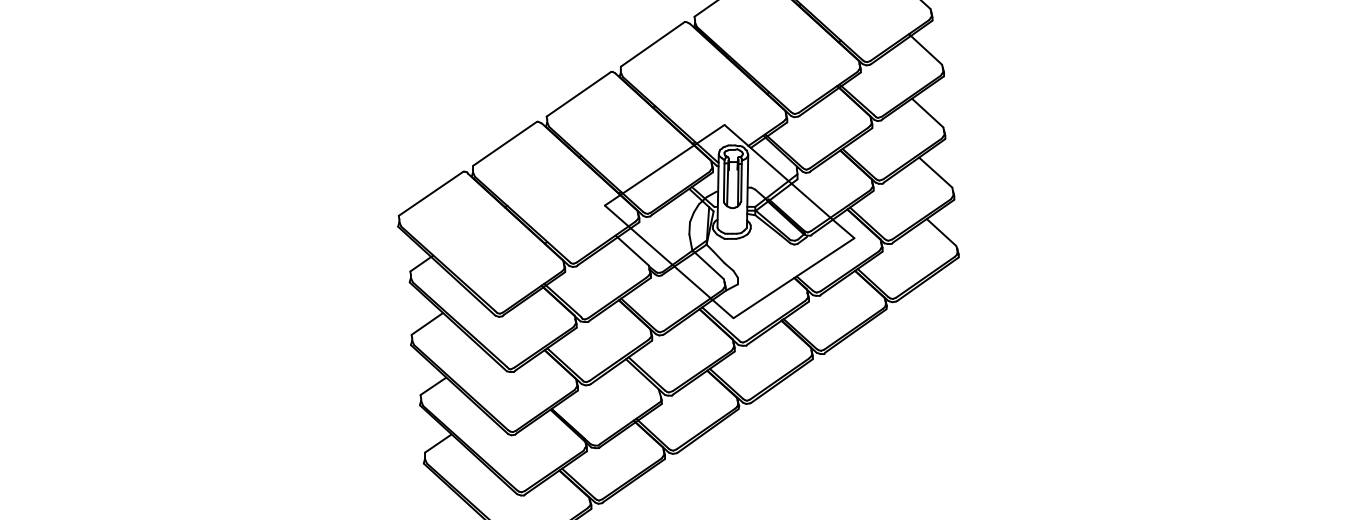

11 Roof Detail @ SHINGLE ROOF VENT PIPE
1 1/2" = 1'-0"

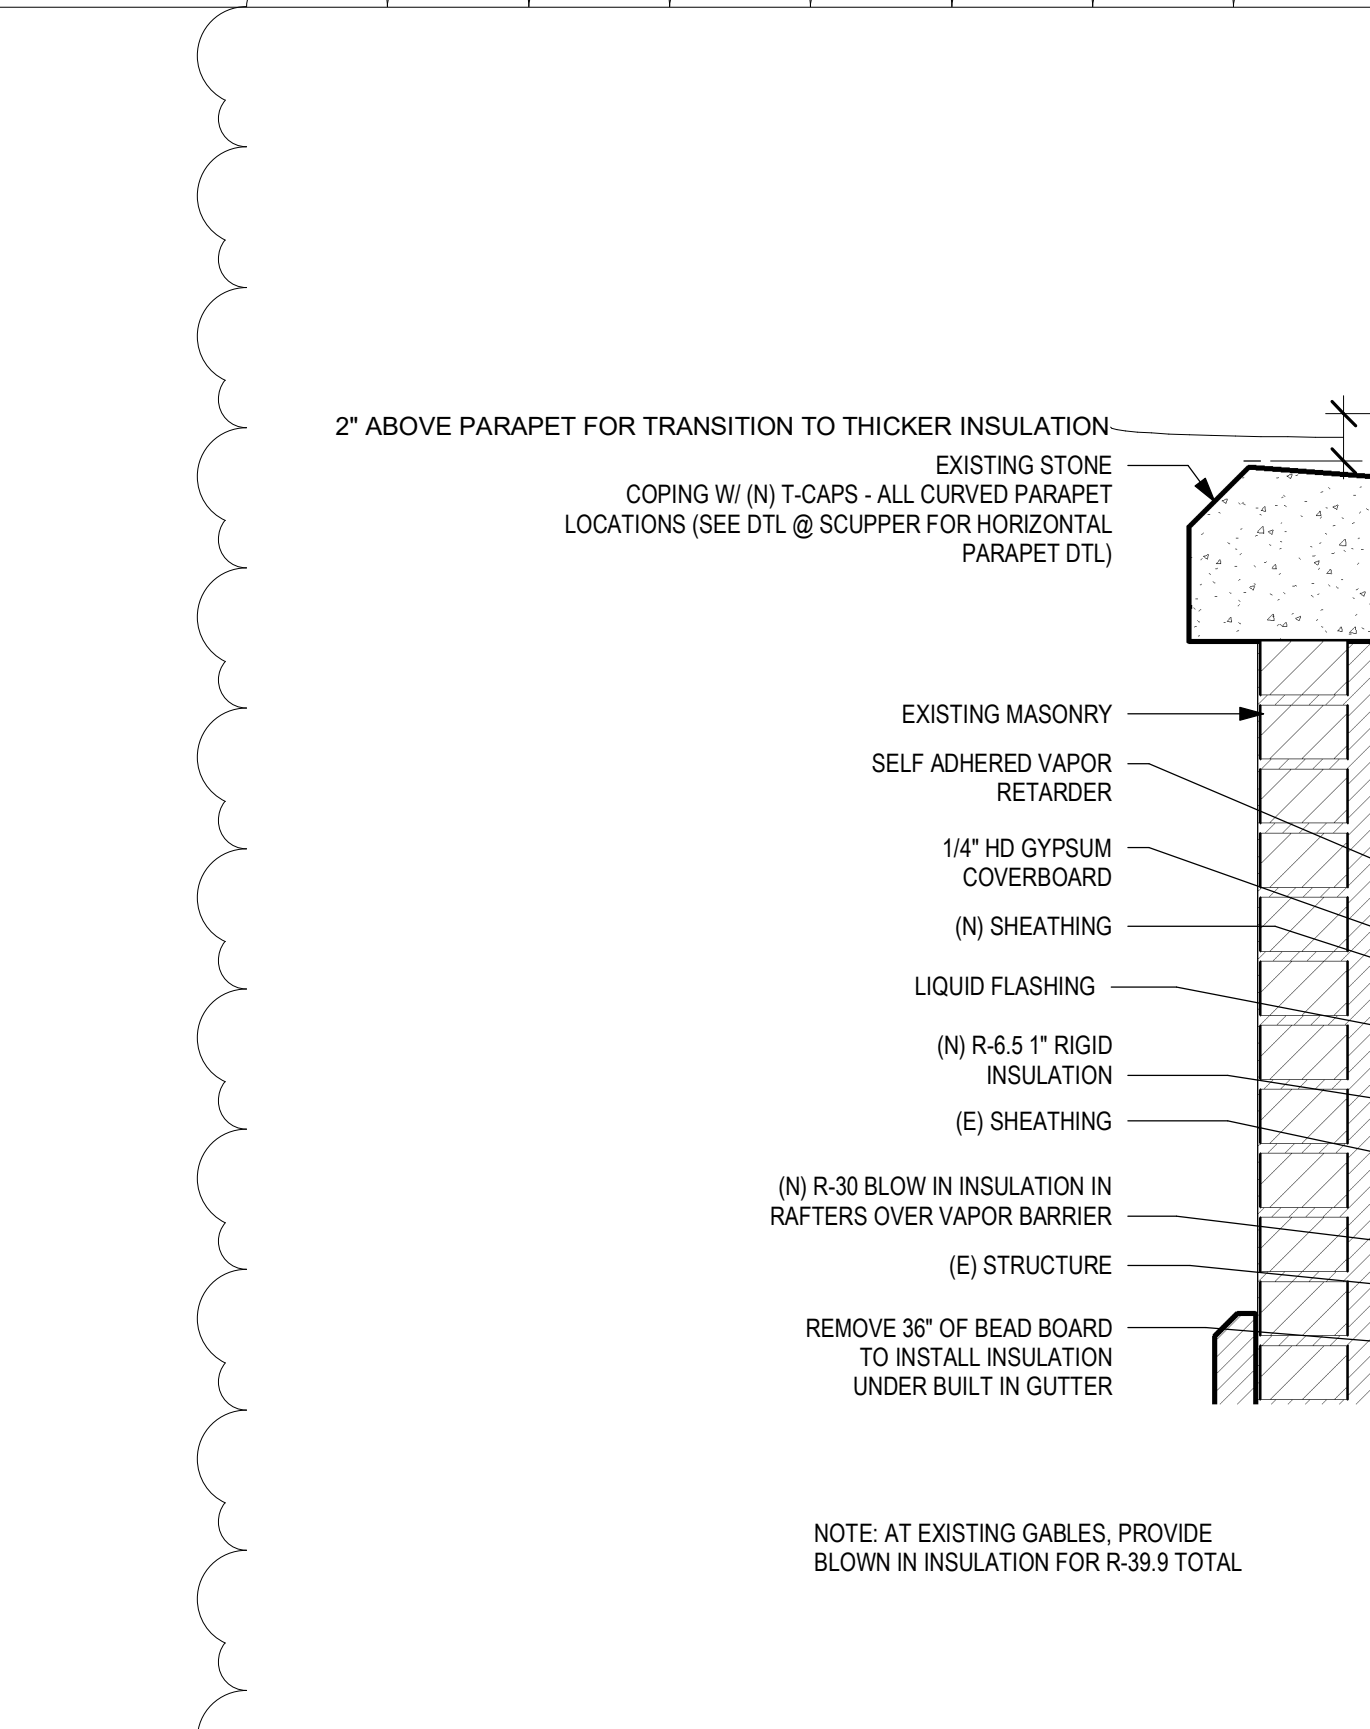

13 DETAIL @ PENETRATION CURB
1 1/2" = 1'-0"

STAMP AREA


WINDOW SCHEDULE

NO.	TYPE	DIMENSION HEIGHT / WIDTH	HEAD	JAMB	SILL	HORIZ. MULLION(S)	MATERIAL	GLAZIN G	NOTES
001	H-1A	3'-0" 4'-0"	4	10	8	N/A	ALUM	GL-E3	SCREEN TYPE: S1-LH
002	H-2	3'-0" 3'-0"	4	10	8	N/A	ALUM	GL-E3	SCREEN TYPE: S1-LH
003	H-2	3'-0" 3'-0"	4	10	8	N/A	ALUM	GL-E3	SCREEN TYPE: S1-RH
004	H-1A	3'-0" 4'-0"	4	10	8	N/A	ALUM	GL-E3	SCREEN TYPE: S1-RH
005	EX MAS INFILL	3'-0" 4'-0"	N/A	N/A	N/A	N/A	N/A	N/A	EXISTING INFILL TO REMAIN
006	EX MAS INFILL	3'-0" 4'-0"	N/A	N/A	N/A	N/A	N/A	N/A	EXISTING INFILL TO REMAIN
007	EX MAS INFILL	3'-0" 4'-0"	N/A	N/A	N/A	N/A	N/A	N/A	EXISTING INFILL TO REMAIN
008	EX MAS INFILL	2'-0" 3'-0"	N/A	N/A	N/A	N/A	N/A	N/A	EXISTING INFILL TO REMAIN
009	EX MAS INFILL	2'-0" 4'-0"	N/A	N/A	N/A	N/A	N/A	N/A	EXISTING INFILL TO REMAIN
010	EX MAS INFILL	2'-0" 4'-0"	N/A	N/A	N/A	N/A	N/A	N/A	EXISTING INFILL TO REMAIN
011	EX MAS INFILL	2'-0" 3'-0"	N/A	N/A	N/A	N/A	N/A	N/A	EXISTING INFILL TO REMAIN
012	EX MAS INFILL	3'-0" 4'-0"	N/A	N/A	N/A	N/A	N/A	N/A	EXISTING INFILL TO REMAIN
013	EX MAS INFILL	3'-0" 4'-0"	N/A	N/A	N/A	N/A	N/A	N/A	EXISTING INFILL TO REMAIN
014	EX MAS INFILL	3'-0" 4'-0"	N/A	N/A	N/A	N/A	N/A	N/A	EXISTING INFILL TO REMAIN
015	H-1A	3'-0" 4'-0"	4	10	8	N/A	ALUM	GL-E3	SCREEN TYPE: S1-LH
016	H-2	3'-0" 3'-0"	4	10	8	N/A	ALUM	GL-E3	SCREEN TYPE: S1-LH
017	H-2	3'-0" 3'-0"	4	10	8	N/A	ALUM	GL-E3	SCREEN TYPE: S1-RH
018	H-1A	3'-0" 4'-0"	4	10	8	N/A	ALUM	GL-E3	SCREEN TYPE: S1-RH
019	EX MAS INFILL	3'-0" 4'-0"	N/A	N/A	N/A	N/A	N/A	N/A	EXISTING INFILL TO REMAIN
020	DH-2A	4'-11" 4'-3"	4	10	8	N/A	ALUM	GL-E3	SCREEN TYPE: S1-LH
021	EX MAS INFILL	5'-0" 4'-0"	N/A	N/A	N/A	N/A	N/A	N/A	EXISTING INFILL TO REMAIN
022	EX MAS INFILL	5'-0" 4'-0"	N/A	N/A	N/A	N/A	N/A	N/A	EXISTING INFILL TO REMAIN
023	EX MAS INFILL	5'-0" 4'-0"	N/A	N/A	N/A	N/A	N/A	N/A	EXISTING INFILL TO REMAIN
024	DH-2A	4'-11" 4'-3"	4	10	8	N/A	ALUM	GL-E3	SCREEN TYPE: S1-LH
025	EX MAS INFILL	5'-0" 4'-0"	N/A	N/A	N/A	N/A	N/A	N/A	EXISTING INFILL TO REMAIN
027	DH-1	5'-3 1/2" 3'-2"	4	10	8	N/A	ALUM	GL-E3	SCREEN TYPE: S1-RH
028	EX MAS INFILL	4'-11" 4'-3"	N/A	N/A	N/A	N/A	N/A	N/A	EXISTING INFILL TO REMAIN
029	EX MAS INFILL	4'-11" 4'-3"	N/A	N/A	N/A	N/A	N/A	N/A	EXISTING INFILL TO REMAIN
030	DH-2	4'-11" 4'-3"	4	10	8	N/A	ALUM	GL-E3	SCREEN TYPE: S1-RH
031	DH-2	4'-11" 4'-3"	4	10	8	N/A	ALUM	GL-E3	SCREEN TYPE: S1-RH
032	DH-2	4'-11" 4'-3"	4	10	8	N/A	ALUM	GL-E3	SCREEN TYPE: S1-RH
033	EX MAS INFILL	4'-11" 4'-3"	N/A	N/A	N/A	N/A	N/A	N/A	EXISTING INFILL TO REMAIN
034	EX MAS INFILL	4'-11" 4'-3"	N/A	N/A	N/A	N/A	N/A	N/A	EXISTING INFILL TO REMAIN
036	DH-2	4'-11" 4'-3"	4	10	8	N/A	ALUM	GL-E3	SCREEN TYPE: S1-LH
037	EX MAS INFILL	5'-0" 4'-0"	N/A	N/A	N/A	N/A	N/A	N/A	EXISTING INFILL TO REMAIN
038	EX MAS INFILL	5'-0" 4'-0"	N/A	N/A	N/A	N/A	N/A	N/A	EXISTING INFILL TO REMAIN
039	DH-2	4'-11" 4'-3"	4	10	8	N/A	ALUM	GL-E3	SCREEN TYPE: S1-LH
040	EX MAS INFILL	3'-0" 4'-0"	N/A	N/A	N/A	N/A	N/A	N/A	EXISTING INFILL TO REMAIN

101	FC-1	6'-8" 6'-6"	3	11	7	12	ALUM	GL-E2	
102	CHA-2A	12'-3" 7'-3"	1	5	10	12	ALUM	GL-E2	
103	FC-1	6'-8" 6'-6"	3	11	7	12	ALUM	GL-E2	
104	CT-1A	8'-2" 5'-8"	3	10/11	5/6	12	ALUM	GL-E2	
105	CT-1	8'-2" 5'-8"	3	11	6	12	ALUM	GL-E2	
106	CT-1	8'-2" 5'-8"	3	11	6	12	ALUM	GL-E2	
107	FCT-1	8'-1" 2'-9"	3	11	6	12	ALUM	GL-E3	SCREEN TYPE: S2-LH
108	CT-2A	8'-2" 4'-3"	3	11	6	12	ALUM	GL-E2	
109	CT-2A	8'-2" 4'-3"	3	11	6	12	ALUM	GL-E2	
110	FCT-1	8'-1" 2'-9"	3	11	6	12	ALUM	GL-E3	SCREEN TYPE: S2-RH
111	CT-1	8'-2" 5'-8"	3	11	6	12	ALUM	GL-E2	
112	CT-1	8'-2" 5'-8"	3	11	6	12	ALUM	GL-E2	
113	CT-1A	8'-2" 5'-8"	3	10/11	5/6	12	ALUM	GL-E2	
114	FC-1	6'-8" 6'-6"	3	11	7	12	ALUM	GL-E2	
115	CHA-2A	12'-3" 7'-3"	1	5	10	12	ALUM	GL-E2	
116	FC-1	6'-8" 6'-6"	3	11	7	12	ALUM	GL-E2	
117	FC-1A	6'-8" 6'-6"	3	11	7	12	ALUM	GL-E2	
118	CHA-2	12'-3" 7'-4"	1	5	10	12	ALUM	GL-E2	
119	FC-1A	6'-8" 6'-6"	3	11	7	12	ALUM	GL-E2	
120	CHA-2	12'-3" 7'-4"	1	5	10	12	ALUM	GL-E2	
121	FC-1A	6'-8" 6'-6"	3	11	7	12	ALUM	GL-E2	
122	FC-1	6'-8" 6'-6"	1	4/5	3	12	ALUM	GL-E2	SCREEN TYPE: S3
123	CHA-2A	12'-3" 7'-3"	1/2/2A	4/5A	3/3A	12	ALUM	GL-E2	SCREEN TYPE: S4
124	FC-1	6'-8" 6'-6"	3	11	7	12	ALUM	GL-E2	

GENERAL NOTES:

- ALL DIMENSIONS ARE APPROXIMATE. CONTRACTOR TO V.I.F.
- NEW WINDOW CONFIGURATIONS SHALL MATCH HISTORIC WOOD FRAME DIMENSIONS AS CLOSELY AS POSSIBLE. ALL WINDOW FRAMES AND MULLIONS SHALL CLOSELY MATCH THE HISTORIC PROFILES IN WIDTH, DEPTH, AND CONFIGURATION. VERIFY IN FIELD (V.I.F.)
- EXISTING PHOTOS ARE FOR REFERENCE TO WINDOW TYPE ONLY.
- SEE A903-R.1 FOR WINDOW DETAILS - U.N.O (SEE SCHEDULE)
- WINDOW TYPES ENDING WITH A NUMBER INDICATES A FIXED SASH. WINDOW TYPES ENDING WITH THE LETTER "A" INDICATES AN OPERABLE SASH. FIXED SASH AND OPERABLE SASH WINDOWS TO HAVE CONSISTENT SIGHTLINES.

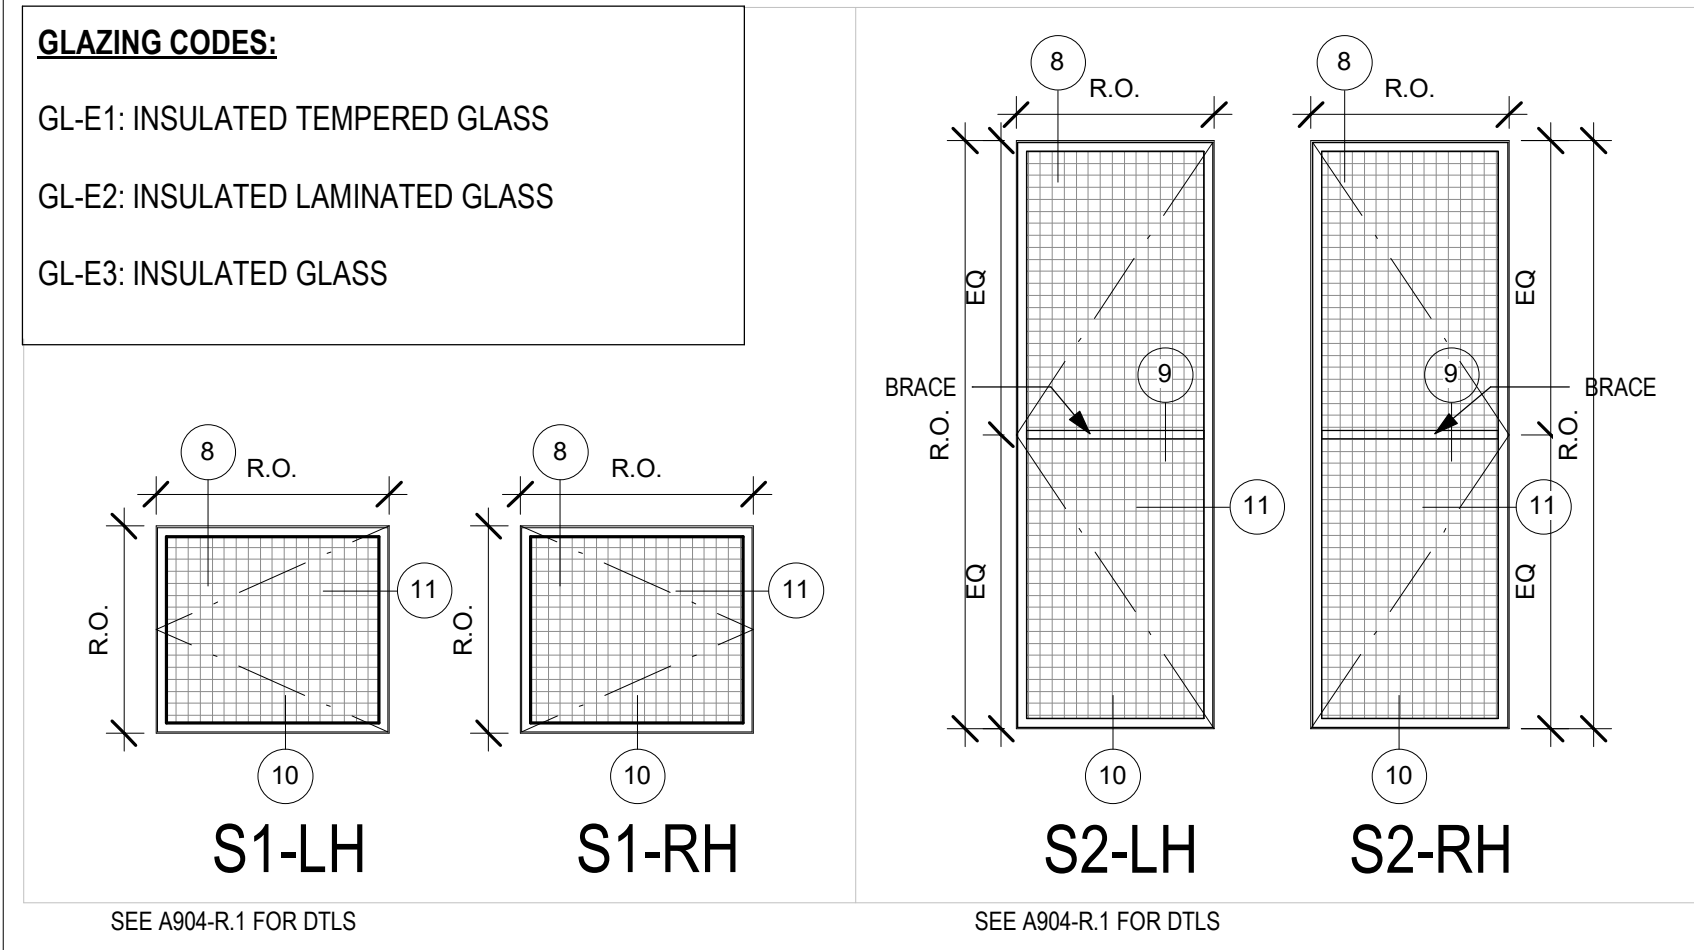

SCREEN TYPES
 3/8" = 1'-0"

STAMP AREA

NO.	TYPE	DIMENSION HEIGHT / WIDTH	HEAD	JAMB	SILL	HORIZ. MULLION(S)	MATERIAL	GLAZIN G	NOTES
125	FC-1A	6'-8" 6'-6"	3	11	7	12	ALUM	GL-E2	
126	CHA-2	12'-3" 7'-4"	1	5	10	12	ALUM	GL-E2	
127	CT-1A	8'-2" 4'-0"	3	11	7	12	ALUM	GL-E2	
128	CT-1	8'-2" 6'-3"	3	11	6	12	ALUM	GL-E2	
129	CT-2A	8'-2" 4'-3"	3	11	6	12	ALUM	GL-E2	
130	CT-1	8'-2" 6'-3"	3	11	6	12	ALUM	GL-E2	
131	CT-2A	8'-2" 4'-3"	3	11	6	12	ALUM	GL-E2	
132	FC-2	5'-0" 4'-0"	4	10	5/6	N/A	ALUM	GL-E2	
133	FC-2	5'-0" 4'-0"	4	10	5/6	N/A	ALUM	GL-E2	
134	CT-2A	8'-2" 4'-3"	3	11	6	12	ALUM	GL-E2	
135	CT-1	8'-2" 6'-3"	3	11	6	12	ALUM	GL-E2	
136	C-2	5'-0" 2'-0"	4	8	10	N/A	ALUM	GL-E2	
137	CT-1	8'-2" 6'-3"	3	11	6	12	ALUM	GL-E2	
138	C-1A	8'-2" 4'-0"	3	11	7	12	ALUM	GL-E2	
139	CHA-2	12'-3" 7'-4"	1	10	7	12	ALUM	GL-E2	
140	FC-1A	6'-8" 6'-6"	3	11	7	12	ALUM	GL-E2	
141	FC-1	6'-8" 6'-6"	1	4/5	3	12	ALUM	GL-E2	
142	CHA-2	12'-3" 7'-4"	1	10	7	12	ALUM	GL-E2	SCREEN TYPE: S4
143	FC-1	6'-8" 6'-6"	1	4/5	3	12	ALUM	GL-E2	SCREEN TYPE: S3
144	FC-1A	6'-8" 6'-6"	3	11	7	12	ALUM	GL-E2	
145	CHA-2	12'-3" 7'-4"	1	10	7	12	ALUM	GL-E2	
146	FC-1A	6'-8" 6'-6"	3	11	7	12	ALUM	GL-E2	
147	CHA-2	12'-3" 7'-4"	1	10	7	12	ALUM	GL-E2	
148	FC-1A	6'-8" 6'-6"	3	11	7	12	ALUM	GL-E2	





201	FCAT-1A	9'-0" 6'-11"	1	10	5	12	ALUM	GL-E3	
202	FCAT-1	9'-2" 6'-11"	1	10	5	12	ALUM	GL-E3	
203	FCAT-1	9'-2" 6'-11"	1	10	5	12	ALUM	GL-E3	
204	FCAT-2	8'-11" 3'-0"	1	10	5	12	ALUM	GL-E2	
205	EX MAS INFILL ARCH	9'-1" 7'-1"	N/A	N/A	N/A	N/A	N/A	N/A	EXISTING INFILL TO REMAIN
206	EX MAS INFILL ARCH	9'-1" 7'-1"	N/A	N/A	N/A	N/A	N/A	N/A	EXISTING INFILL TO REMAIN
207	EX MAS INFILL ARCH	9'-1" 7'-1"	N/A	N/A	N/A	N/A	N/A	N/A	EXISTING INFILL TO REMAIN
208	FCAT-2	8'-11" 3'-0"	1	10	5	12	ALUM	GL-E2	
209	FCAT-1	9'-2" 6'-11"	1	10	5	12	ALUM	GL-E3	
210	FCAT-1	9'-2" 6'-11"	1	10	5	12	ALUM	GL-E3	
211	FCAT-1A	9'-0" 6'-11"	1	10	5	12	ALUM	GL-E3	
212	EX MAS INFILL ARCH	9'-1" 7'-1"	N/A	N/A	N/A	N/A	N/A	N/A	EXISTING INFILL TO REMAIN
213	EX MAS INFILL ARCH	9'-1" 7'-1"	N/A	N/A	N/A	N/A	N/A	N/A	EXISTING INFILL TO REMAIN
214	EX MAS INFILL ARCH	9'-1" 7'-1"	N/A	N/A	N/A	N/A	N/A	N/A	EXISTING INFILL TO REMAIN
215	FCAT-1A	9'-0" 6'-11"	1	10	5	12	ALUM	GL-E3	
216	FCAT-1	9'-2" 6'-11"	1	10	5	12	ALUM	GL-E3	
217	CAT-1	8'-8" 5'-1"	1	10	5	12	ALUM	GL-E3	
218	CAT-1A	8'-8" 4'-3"	1	10	5	12	ALUM	GL-E3	
219	CAT-1	8'-8" 4'-3"	1	10	5	12	ALUM	GL-E3	
220	FCAT-1	9'-2" 6'-11"	3	4 / 1 / A904-R.1	A904-R.1	3 / A904-R.1	WD	GL-E3	EXISTING WD FRAME & TRIM TO REMAIN. NEW MTL. SASH. CLAD W/ MTL PANNING

221	CHA-1A	16'-3" 8'-0"	3	4 / 1 / A904-R.1	A904-R.1	3 / A904-R.1	WD	GL-E3	EXISTING WD FRAME & TRIM TO REMAIN. NEW MTL. SASH. CLAD W/ MTL PANNING
222	FCAT-1	9'-2" 6'-11"	3	4 / 1 / A904-R.1	A904-R.1	3 / A904-R.1	WD	GL-E3	EXISTING WD FRAME & TRIM TO REMAIN. NEW MTL. SASH. CLAD W/ MTL PANNING

223	CAT-1	8'-8" 4'-3"	1	10	5	12	ALUM	GL-E3	
224	CAT-1	8'-8" 4'-3"	1	10	5	12	ALUM	GL-E3	
225	CAT-1	8'-8" 5'-1"	1	10	5	12	ALUM	GL-E3	
226	FCAT-1	9'-2" 6'-11"	1	10	5	12	ALUM	GL-E3	
227	FCAT-1	9'-2" 6'-11"	1	10	5	12	ALUM	GL-E3	
228	EX MAS INFILL ARCH	9'-1" 7'-1"	N/A	N/A	N/A	N/A	N/A	N/A	EXISTING INFILL TO REMAIN
229	EX MAS INFILL ARCH	9'-1" 7'-1"	N/A	N/A	N/A	N/A	N/A	N/A	EXISTING INFILL TO REMAIN
230	EX MAS INFILL ARCH	9'-1" 7'-1"	N/A	N/A	N/A	N/A	N/A	N/A	EXISTING INFILL TO REMAIN
231L	L-1	3'-0" 5'-4"	5 / 7 / A904-R.1	6 / A904-R.1	6 / A904-R.1	N/A	N/A	N/A	SEE MEP DWGS
232L	L-1	3'-0" 5'-4"	5 / 7 / A904-R.1	6 / A904-R.1	6 / A904-R.1	N/A	N/A	N/A	SEE MEP DWGS
233L	L-1	3'-0" 5'-4"	5 / 7 / A904-R.1	6 / A904-R.1	6 / A904-R.1	N/A	N/A	N/A	SEE MEP DWGS
234L	L-1	3'-0" 5'-4"	5 / 7 / A904-R.1	6 / A904-R.1	6 / A904-R.1	N/A	N/A	N/A	SEE MEP DWGS

301	A-1	2'-0" 4'-0"	13	15	14	N/A	ALUM	GL-E3	
302	A-1	2'-0" 4'-0"	13	15	14	N/A	ALUM	GL-E3	
303L	L-1	2'-0" 4'-0"	5 / 7 / A904-R.1	6 / A904-R.1	6 / A904-R.1	N/A	N/A	N/A	SEE MEP DWGS
304L	L-1	2'-0" 4'-0"	5 / 7 / A904-R.1	6 / A904-R.1	6 / A904-R.1	N/A	N/A	N/A	SEE MEP DWGS
305L	L-1	2'-0" 4'-0"	5 / 7 / A904-R.1	6 / A904-R.1	6 / A904-R.1	N/A	N/A	N/A	SEE MEP DWGS
306L	L-1	2'-0" 4'-0"	5 / 7 / A904-R.1	6 / A904-R.1	6 / A904-R.1	N/A	N/A	N/A	SEE MEP DWGS

WINDOW TYPE

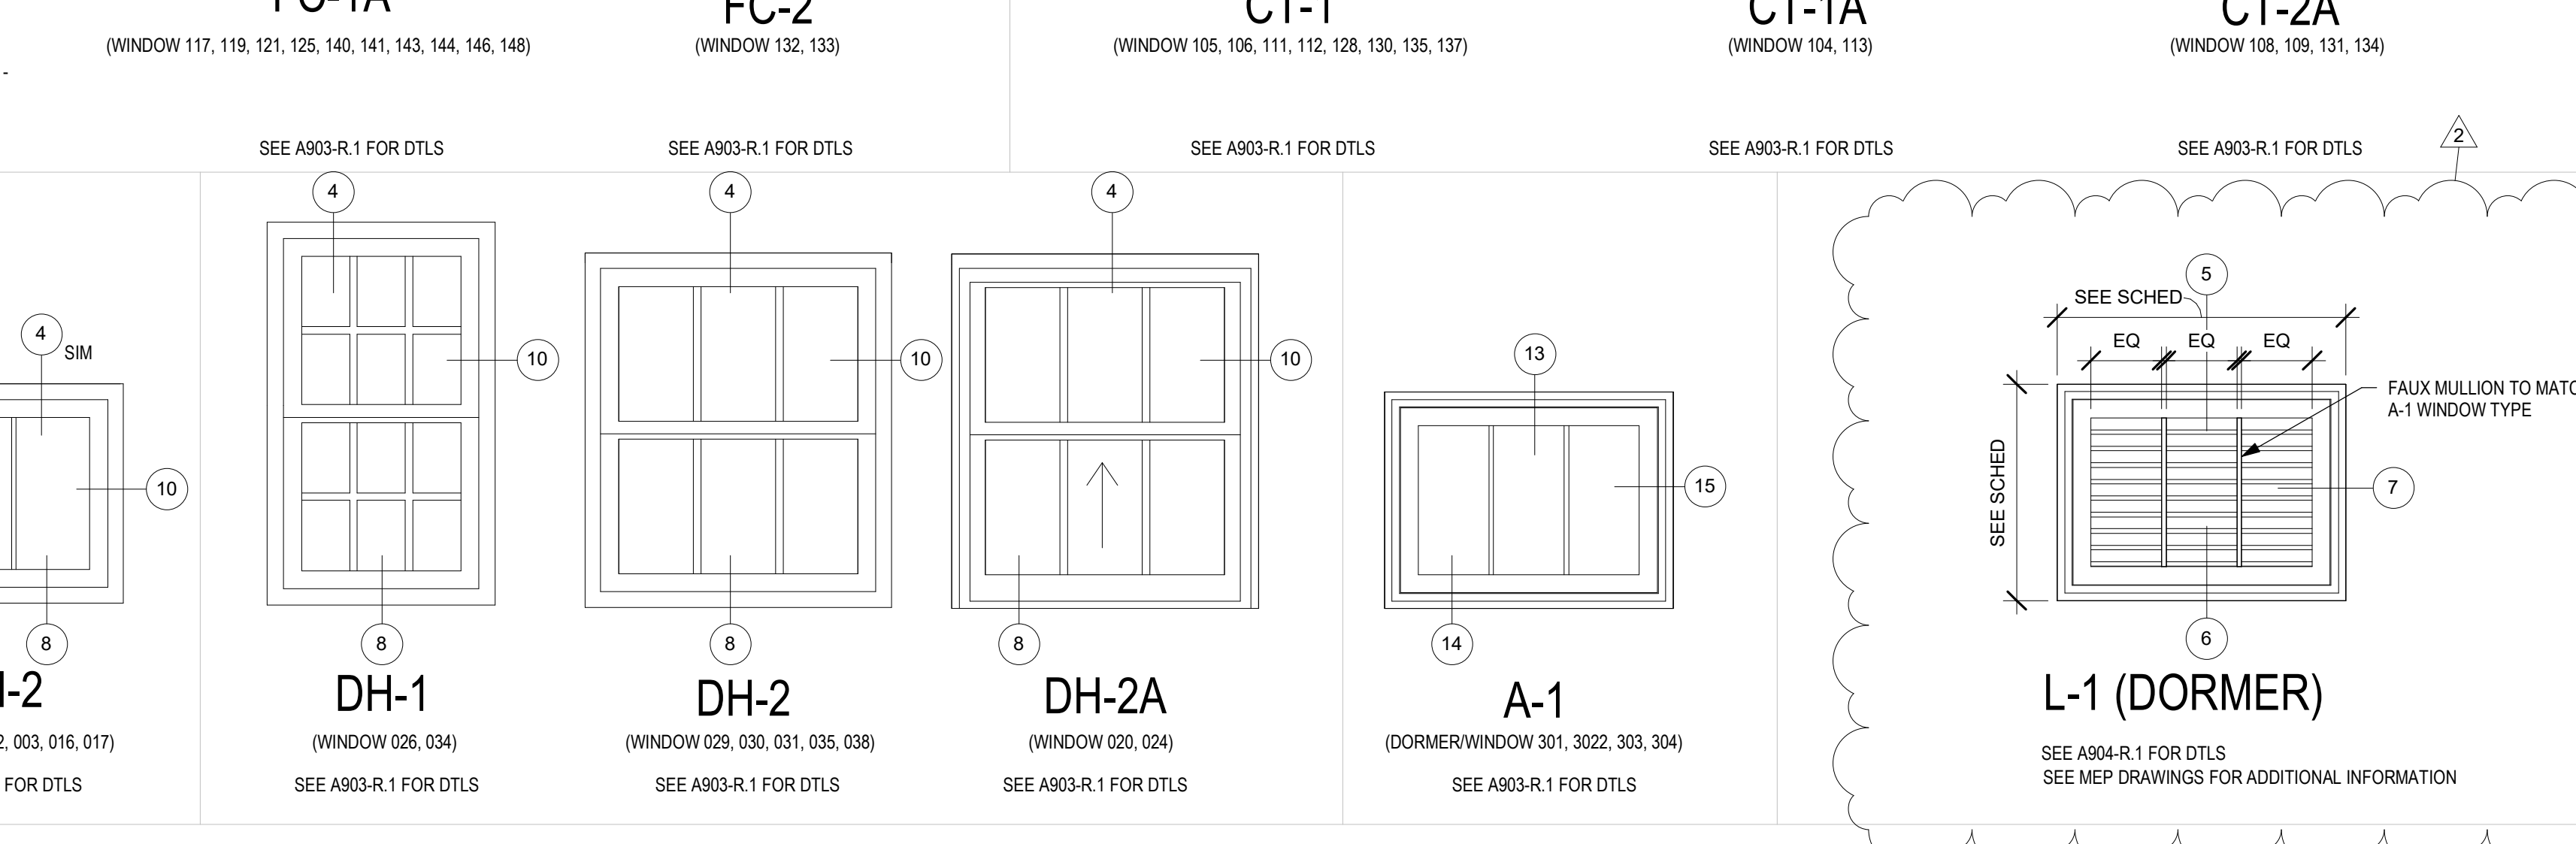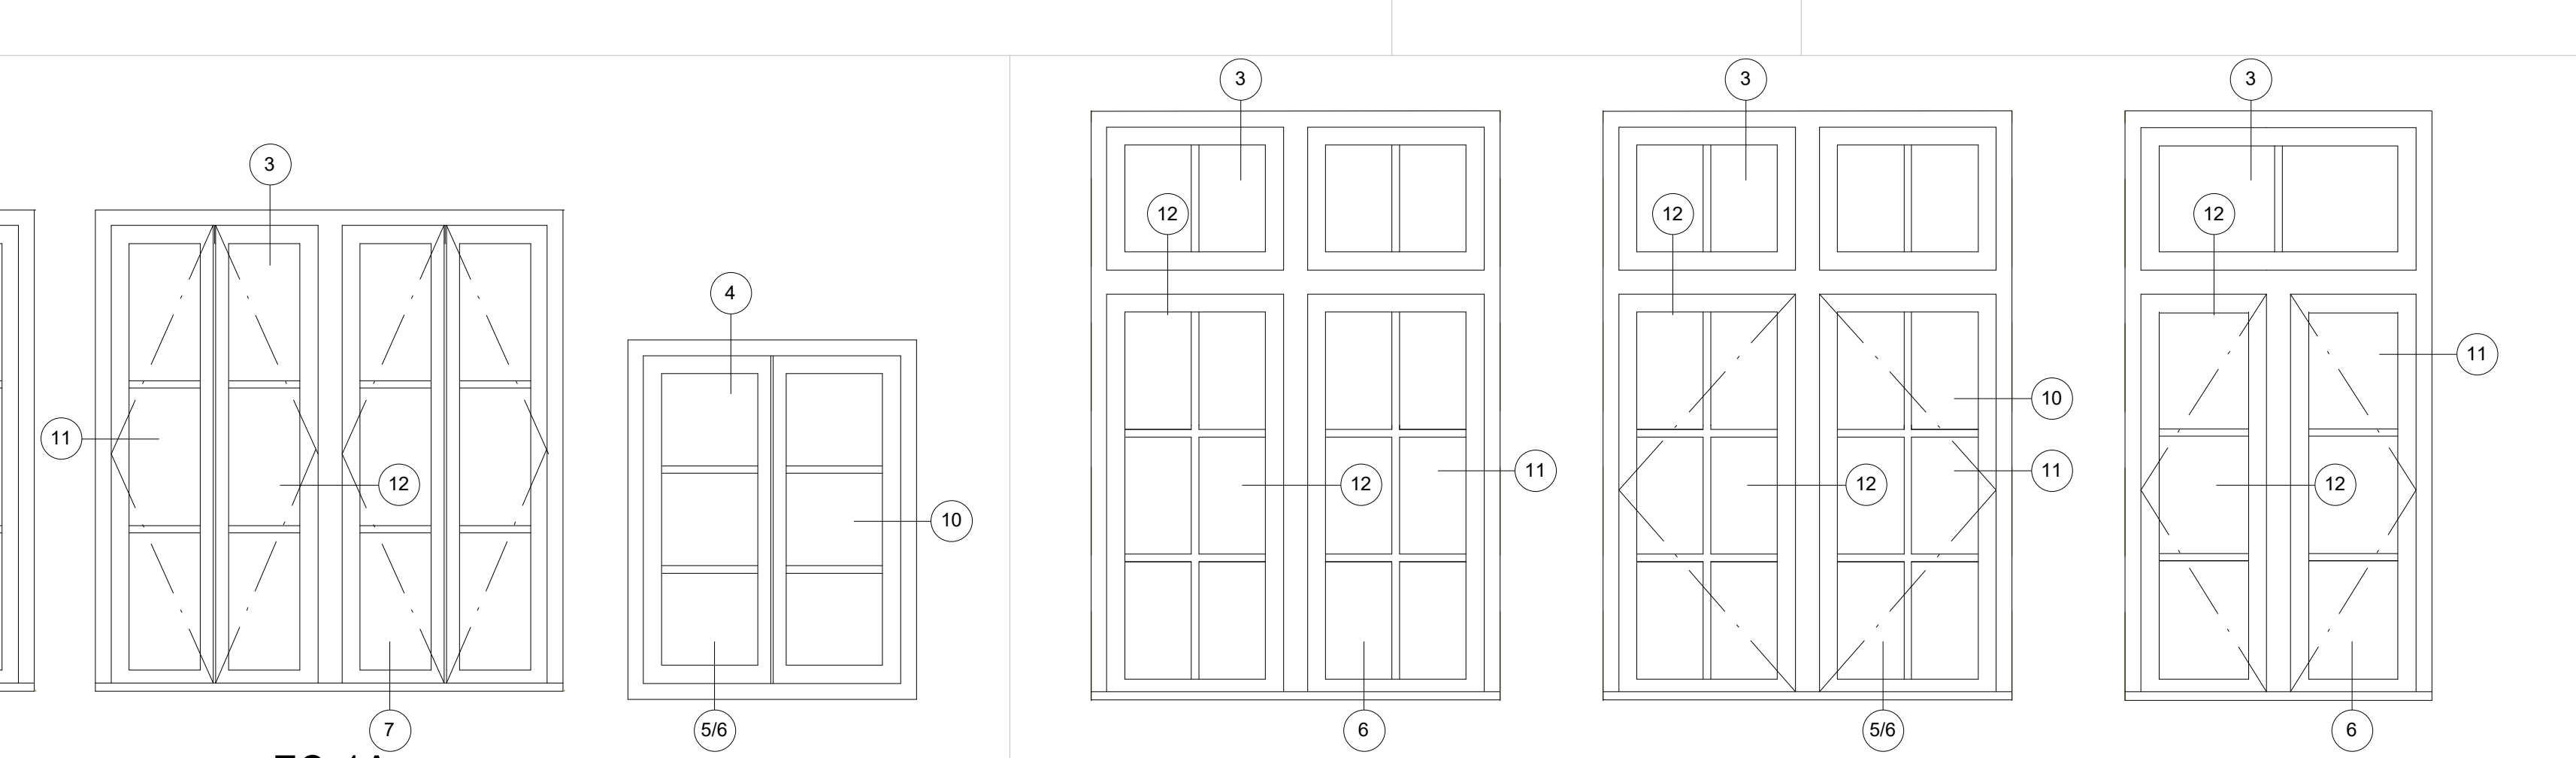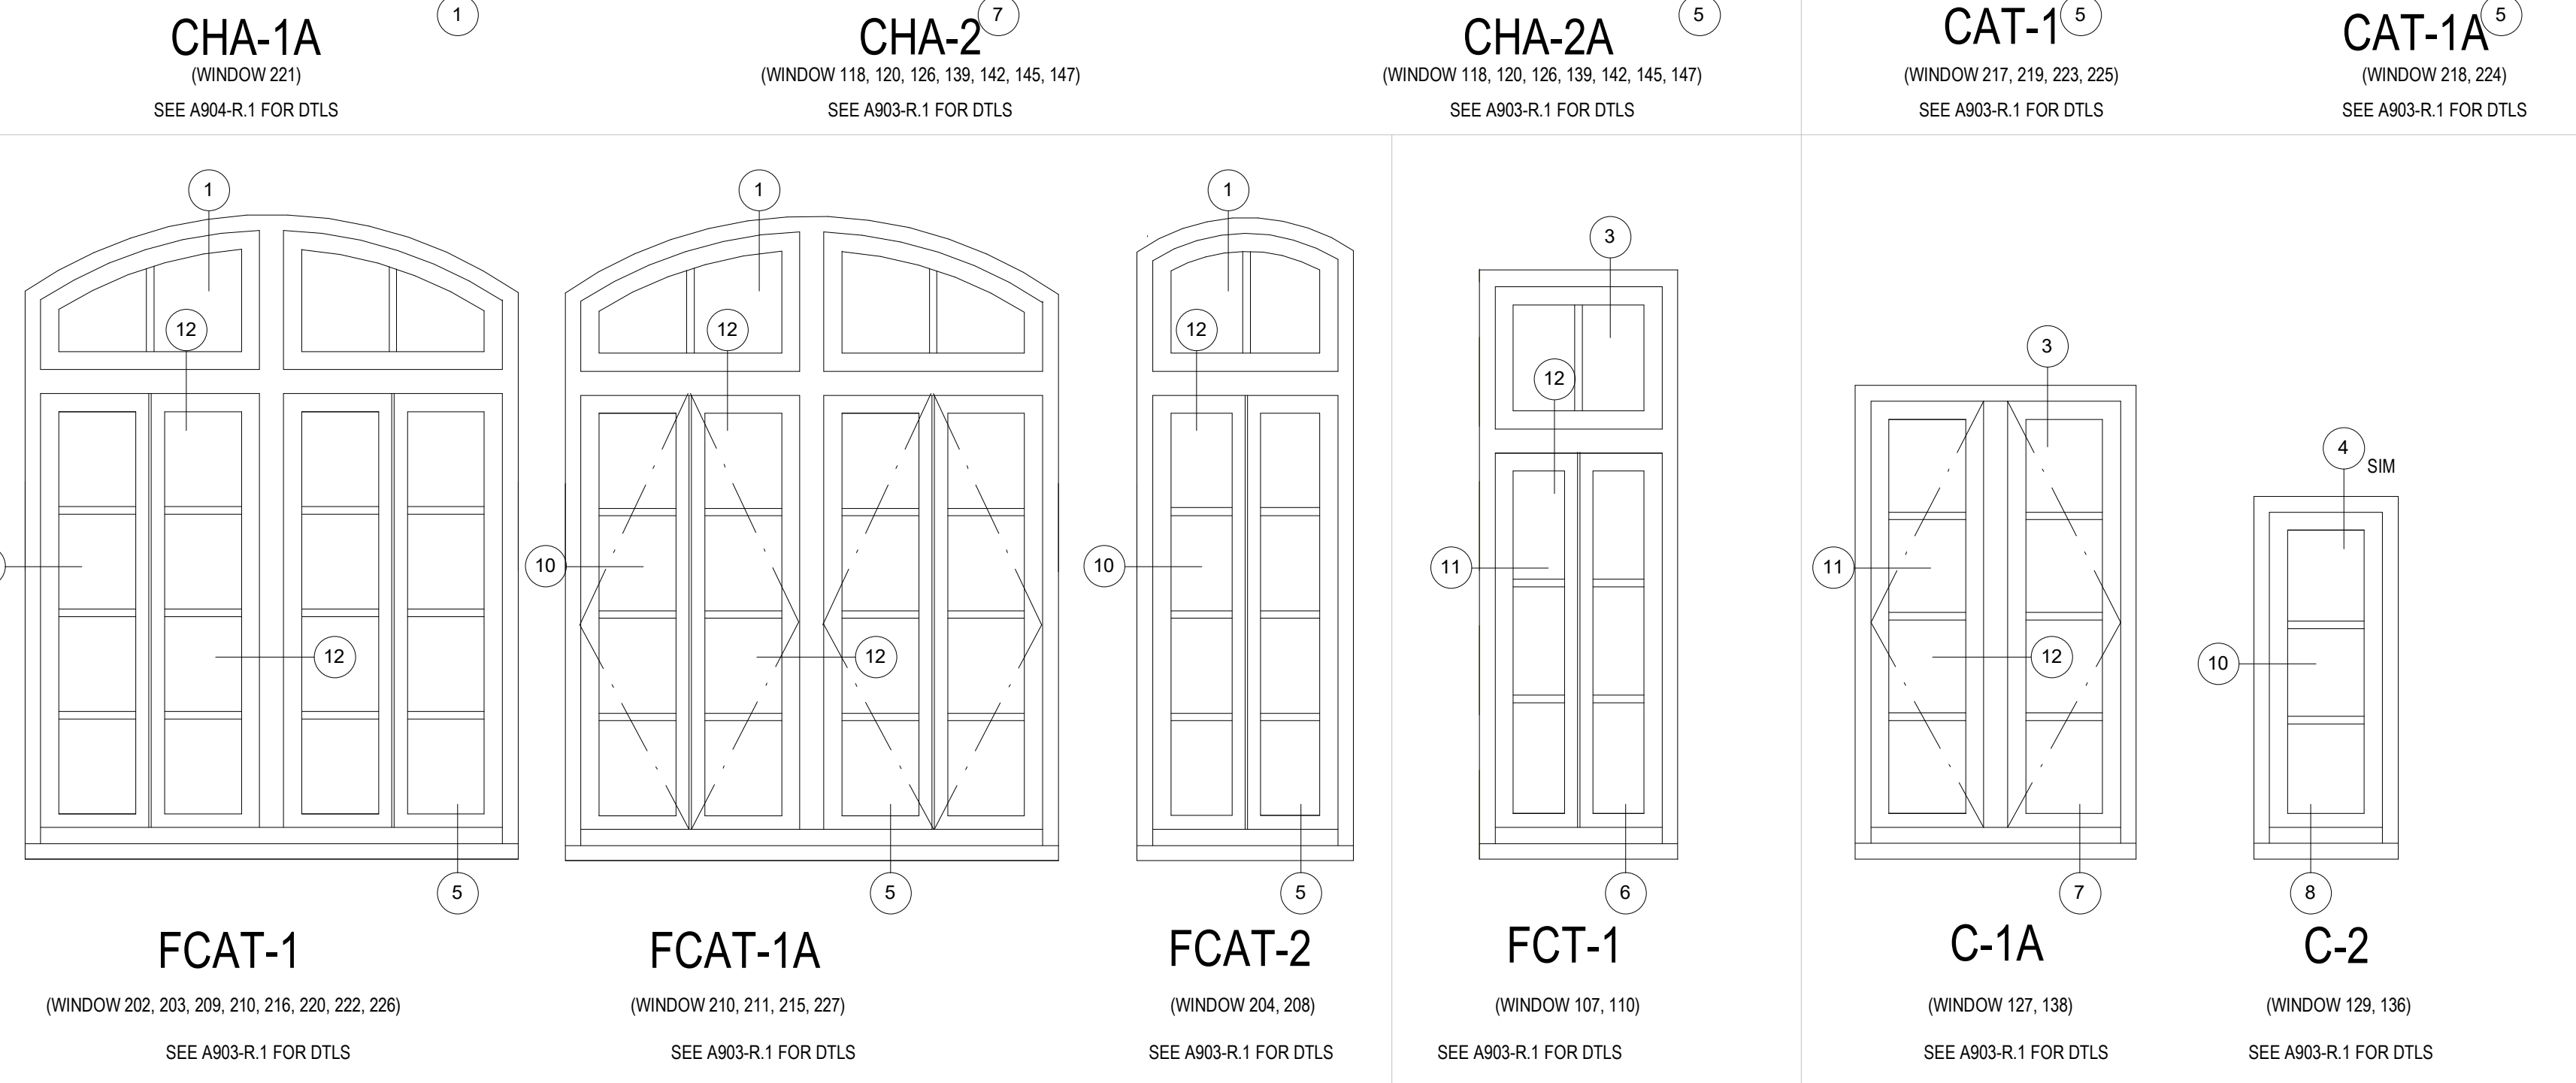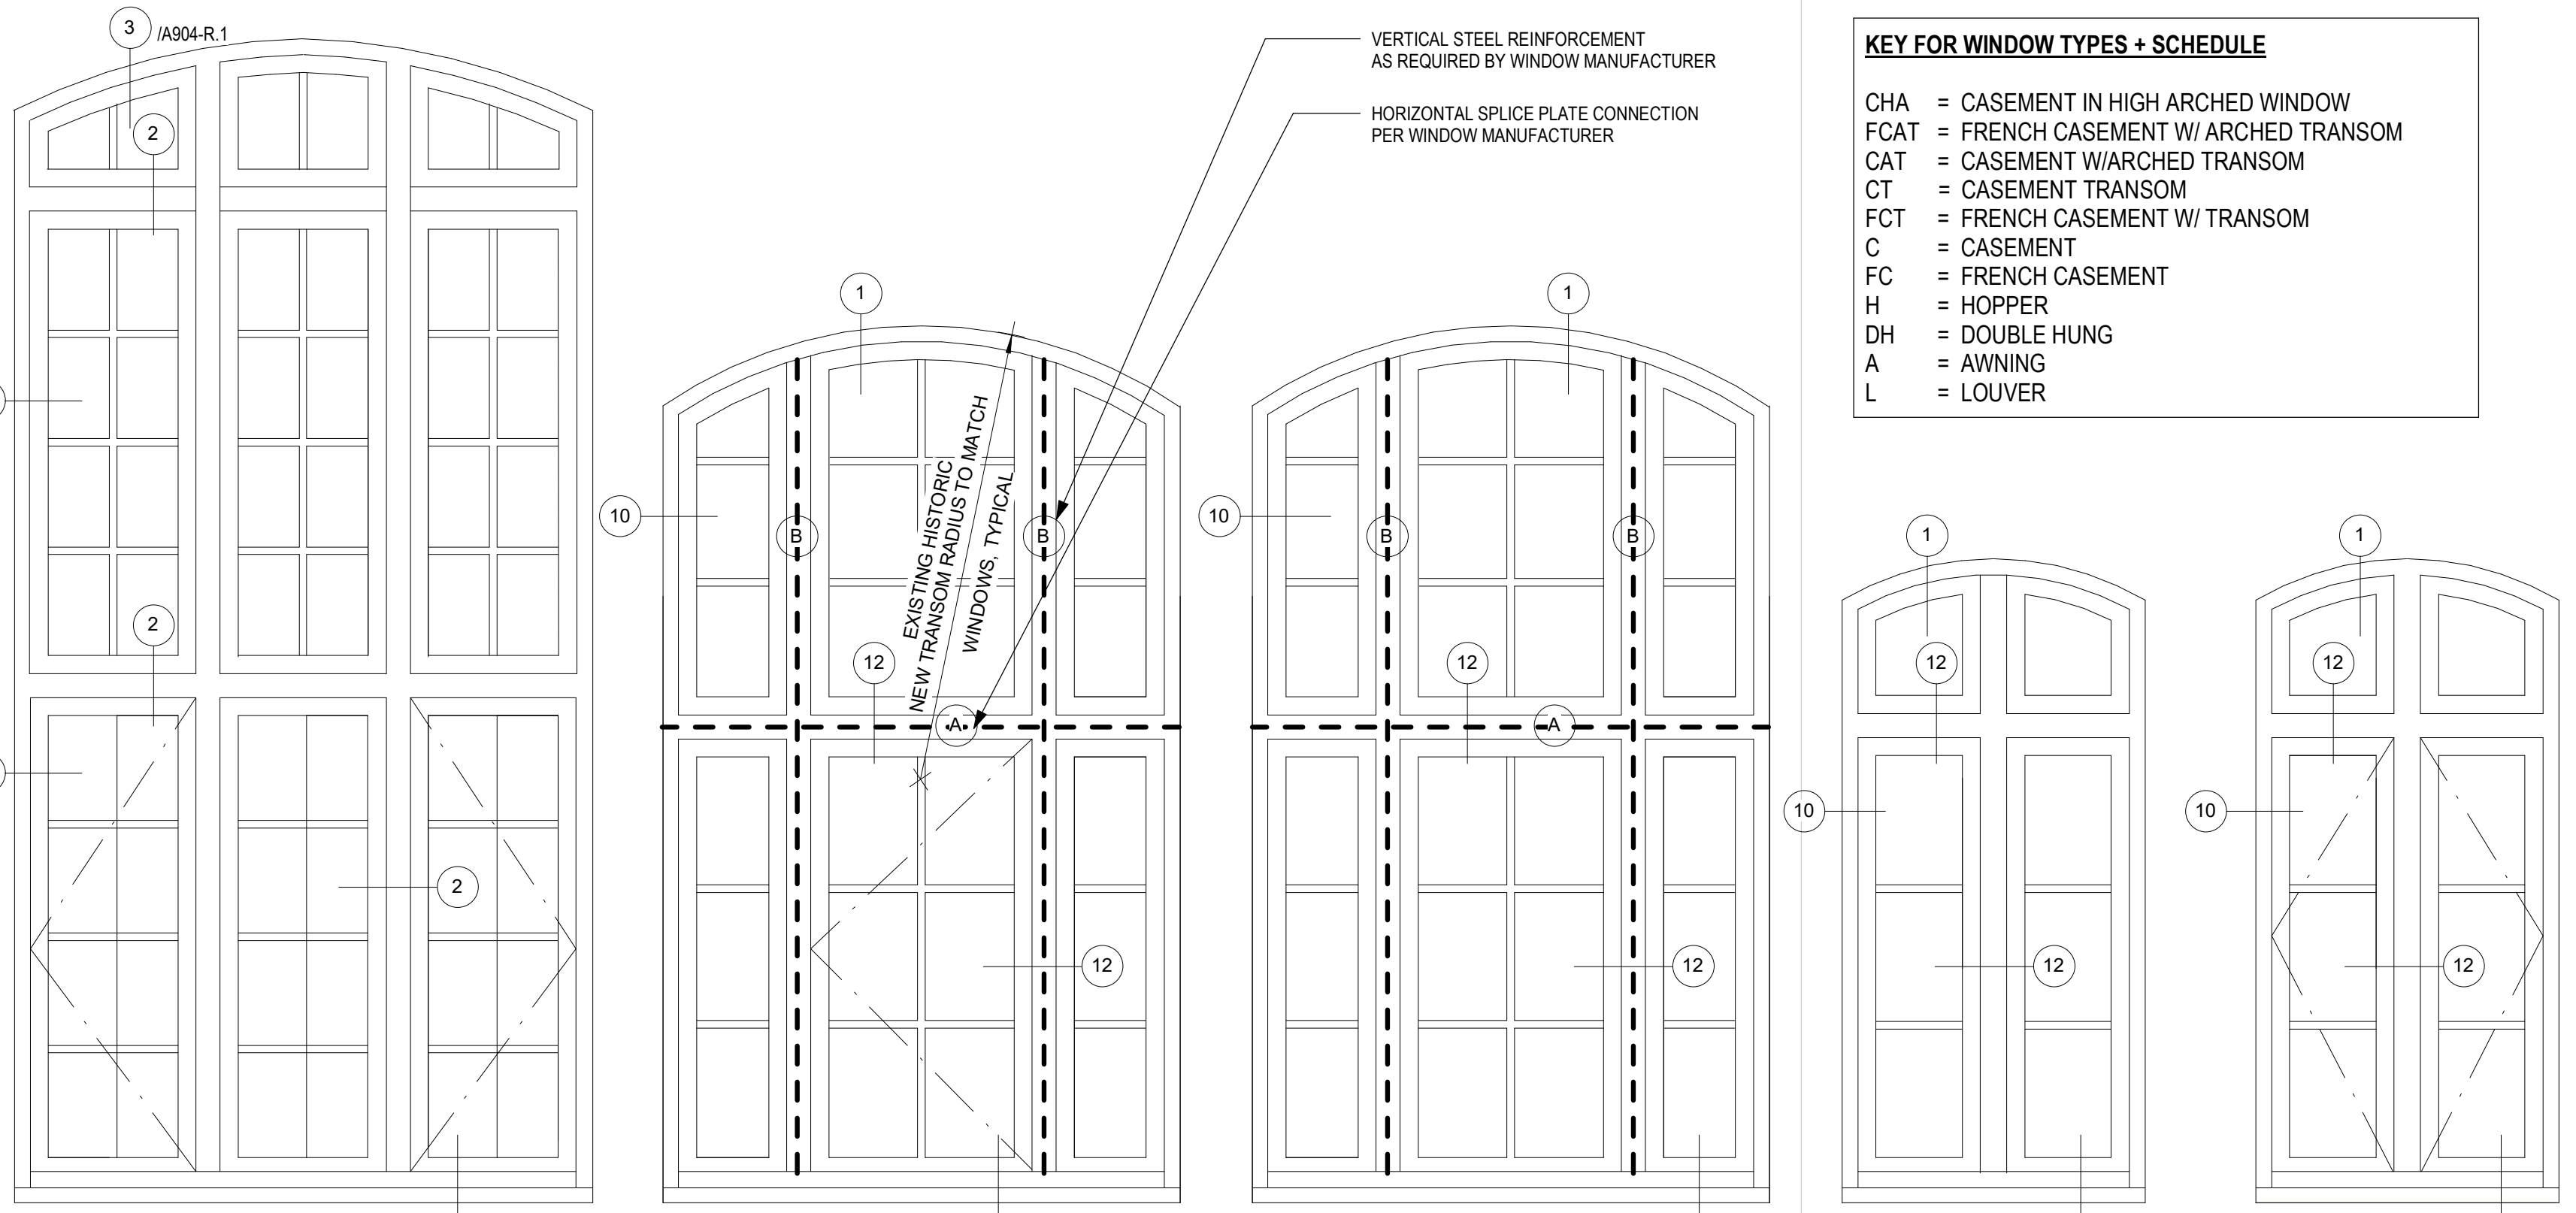

WINDOW TYPES
 1/2" = 1'-0"

KEY FOR WINDOW TYPES + SCHEDULE

CHA = CASEMENT IN HIGH ARCHED WINDOW
 FCAT = FRENCH CASEMENT W/ ARCHED TRANSOM
 CAT = CASEMENT W/ ARCHED TRANSOM
 CT = CASEMENT TRANSOM
 FCT = FRENCH CASEMENT W/ TRANSOM
 C = CASEMENT
 FC = FRENCH CASEMENT
 H = HOPPER
 DH = DOUBLE HUNG
 A = AWNING
 L = LOUVER

REVISIONS